

UNION
N 2007
10/31/77

MISSISSIPPI
BOARD OF WATER COMMISSIONERS
416 North State Street
Jackson, Mississippi 39201

WATER WELL DRILLERS LOG

Oct 31 19 77 J. W. Welch & Sons Union
date well completed firm name county well located

LANDOWNER: Henry Kemp
Blue Springs
(mailing address)

description of formations encountered	from	to
Soil	0	1
Mud	1	33
Blue Rock	33	285
Water Rock	285	284
Water-Sand	284	400

WELL LOCATION:
sec. 13 T 83 N R 4 E
S
3 miles East of Blue Springs
(distance) (direction) (nearest town)

WELL PURPOSE:
(home, irrigation, municipal, industrial)

- WELL COMPLETION DATA:
- (1) diameter (inches) 5
 - (2) total depth (feet) 400'
 - (3) static water level (feet) 181 below top of ground.
 - (4) casing Steel 4 1/2' (material) (depth)
 - (5) screen (size) if telescope see back. (length) (depth to top)
 - (6) pump 1/2 HP 5 (HP) (yield gpm)
Electric (type power)
 - (7) electric log (yes or no)
(organization running log)
 - (8) how well bottom plugged Open


DRILLERS REMARKS:

RECEIVED
FEB - 9 1978

MISS. BD. OF WATER COMM

If well telescopes please sketch and show depths.

GROUND LEVEL

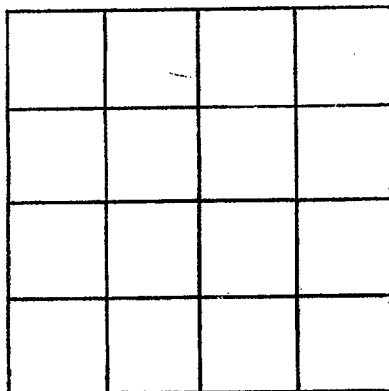

SECTION _____

Please indicate well location X.

ADDITIONAL INFORMATION

If more than one screen, show locations of each on sketch.