

UNION

N 2008

6-78

MISSISSIPPI
 BOARD OF WATER COMMISSIONERS
 416 North State Street
 Jackson, Mississippi 39201

WATER WELL DRILLERS LOG

June 1978 J.W. Webb & Sons Union
 date well completed firm name county well located

LANDOWNER: Mary Kristina
Blue Springs

description of formations encountered	from	to
Soil	0	2
Boulder & Clay	21	32
Blue Rock	32	296
Water Rock	296	298
Water Sand	298	400
Sand & Blue Rock	400	470
Copposand		

(mailing address)

WELL LOCATION:

sec. 7 T. 95 N R. 5 E
4 miles N East of Shema
 (distance) (direction) (nearest town)

WELL PURPOSE:

(home, irrigation, municipal, industrial)

WELL COMPLETION DATA:

- (1) diameter (inches) 5
- (2) total depth (feet) 470
- (3) static water level (feet) 174 below top of ground.
- (4) casing Steel 42'
 (material) (depth)
- _____ If telescope see back.
 (size)
- (5) screen _____
 (length) (depth to top)
- _____ (size) _____ (material)
- (6) pump 1/2 Husk 8
 (HP) (yield gpm)
- elec
 (type power)
- (7) electric log _____
 (yes or no)
- _____ (organization running log)
- (8) how well bottom plugged _____

DRILLERS REMARKS:


RECEIVED

AUG 10 1978

MISS. BD. OF WATER COMMISSIONERS

If well telescopes please sketch and show depths.

GROUND LEVEL

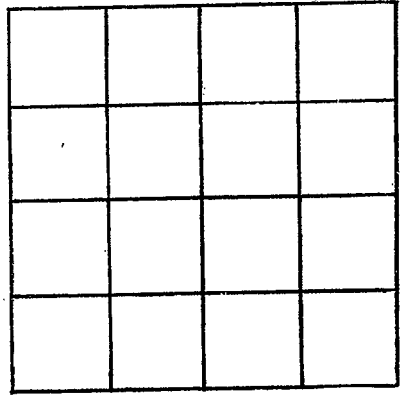

SECTION _____

Please indicate well location X.

ADDITIONAL INFORMATION

If more than one screen,
show locations of each on sketch.