

Union
 N 2010
 12-79

MISSISSIPPI
 BOARD OF WATER COMMISSIONERS
 416 North State Street
 Jackson, Mississippi 39201

WATER WELL DRILLERS LOG

CODED
 Union

DEC 19 79 date well completed
 LEPPER Drilling firm name
 Union county well located

LANDOWNER:
 Carolyn McCord
 New Harmony Community
 New Albany (mailing address) MS

description of formations encountered	from	to
Top clay	0	10
Top sand	10	90
Blue clay	90	150
SAND	150	160

WELL LOCATION:
 sec. 17 T 8 N R 4 E
 S W

(distance) miles (direction) of (nearest town)

WELL PURPOSE:
 (home, irrigation, municipal, industrial)

- WELL COMPLETION DATA:
- (1) diameter (inches) 4
 - (2) total depth (feet) 160
 - (3) static water level (feet) 100 below top of ground.
 - (4) casing PVC 120 (material) (depth)
 4 (size) If telescope see back.
 - (5) screen wire (length) (depth to top)
 (size) (material)
 - (6) pump 1 HP SET (HP) (yield gpm)
 electric 46 PM (type power)
 - (7) electric log (yes or no)
 - (organization running log)
 - (8) how well bottom plugged OPEN


DRILLERS REMARKS:

DEPT OF NATURAL RESOURCES
 BUREAU OF LAND & WATER RESOURCES

FEB 11 1980
 RECEIVED

If well telescopes please sketch and show depths.

GROUND LEVEL

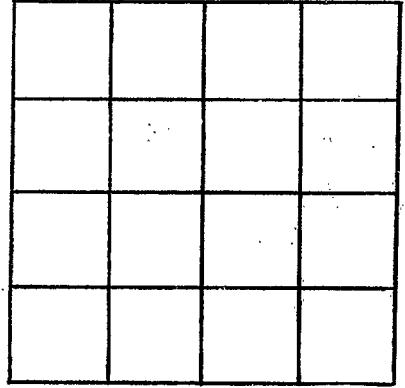

SECTION _____

Please indicate well location X.

ADDITIONAL INFORMATION

If more than one screen,
show locations of each on sketch.