

WALTHALL

A

CODED

MISSISSIPPI BOARD OF WATER COMMISSIONERS
416 North State Street
Jackson, Mississippi 39201

WATER WELL DRILLERS LOG

March 8 1968 *Delores Well & Pump - Walthall*
date well completed firm name county well located

LANDOWNER: *Leroy Boyd*
RFED I, J
Jagers, Miss.
(mailing address)

description of formations encountered	from	to
<i>Red clay</i>	<i>0</i>	<i>10</i>
<i>Red sand & gravel</i>	<i>10</i>	<i>42</i>
<i>Red cherty sand</i>	<i>42</i>	<i>60</i>
<i>Red sand & gravel</i>	<i>60</i>	<i>93</i>
<i>Sandy clay and gravel</i>	<i>93</i>	<i>115</i>
<i>Dark chert</i>	<i>115</i>	<i>120</i>
<i>Red gravel</i>	<i>120</i>	<i>129</i>

WELL LOCATION:
sec. 12 T. 4 N. R. 9 E.
4 miles NE of Princeton
(distance) (direction) (nearest town)

WELL PURPOSE: Home
(home, irrigation, municipal, industrial)

WELL COMPLETION DATA:


- (1) diameter (inches) 4"
- (2) total depth (feet) 129
- (3) static water level (feet) 85 below surface top of ground.
- (4) casing Plastic Bottom
(material) (depth)
(size) if telescope see back.
- (5) screen 6' 123'
(length) (depth to top)
4" Plastic
(size) (material)
- (6) pump 3/4 Sub 15
(HP) (yield gpm)
Electric
(type power)
- (7) electric log NO
(yes or no)
(organization running log)

(8) how well bottom plugged.
wooden plug
DRILLERS REMARKS:
New house



If well telescopes please sketch and show depths.

GROUND LEVEL

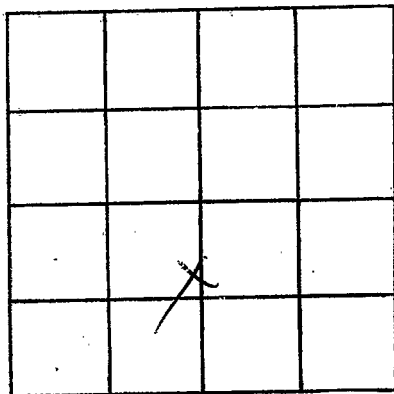

SECTION 12

Please indicate well location X.

ADDITIONAL INFORMATION

If more than one screen, show locations of each on sketch.