

WALTHALL

A

7-14-66

MISSISSIPPI BOARD OF WATER COMMISSIONERS

WATER WELL DRILLERS LOG

Walthall

Date: July 14, 1966, Driller: W.J. Fitzgerald County: Pike

1) Owner of Land: A. D. Lawrence (Name) Sycamore (Address)

Table with 3 columns: Description & Color of Materials, Thickness Feet, Depth Feet. Rows include Topsoil, Sand + P. Gravel, Coarse gravel, Chalk, Coarse gravel + Sand.

2) Location: 1/4, 1/4, Sec. 19 T4 R10E 15 miles E of McComb (distance) (direction) (Nearest Town)

3) Topography: (Hilly) (Flat) (Level)

4) Purpose of Well: (Domestic Irrigation) (Municipal, Industrial, Other)

Information upon completion of well:

1) Diameter 4 inches.

2) Total Depth 82 feet.

3) Water Level 50 feet below top of ground.

4) Cased to 74, Size 4

5) Screen: Size 4", Length 8"

6) Were any formations sealed against pollution? yes, no.


If YES depth of formation Why

Drillers Remarks:

Yield in gpm:

Size pump:

Type power:

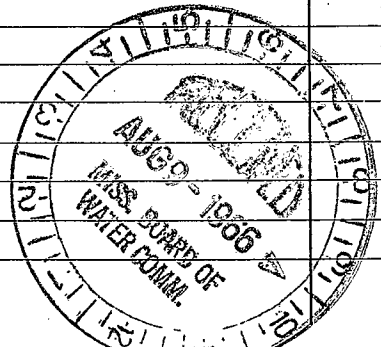

1
2
3