

WALTHALL  
 A8  
 3-68 CODED

MISSISSIPPI  
 BOARD OF WATER COMMISSIONERS  
 416 North State Street  
 Jackson, Mississippi 39201

WATER WELL DRILLERS LOG

Walthall

3-25  
 date well completed

1968 Fitzgerald Water Well  
 firm name

county well located

LANDOWNER: Edward Greer  
 Jayess Miss Rt-

description of formations encountered	from	to
top soil & clay	0	15
sand	15	35
gravelly sand	35	55
sand	55	85
gravelly sand	85	98
red shales	98	115
clayey sand	115	140
dark gravel	140	150

(mailing address)

WELL LOCATION:

sec. 12 T. 4 N. 9 E. W. W  
 S. S R. 9 E. W. W  
 miles \_\_\_\_\_ of \_\_\_\_\_  
 (distance) (direction) (nearest town)

WELL PURPOSE: home  
 (home, irrigation, municipal, industrial)

WELL COMPLETION DATA:


- (1) diameter (inches) 4"
- (2) total depth (feet) 135
- (3) static water level (feet) 90 below above top of ground.
- (4) casing plastic 129  
 (material) (depth)  
4 if telescope see back.  
 (size)
- (5) screen 6' 129  
 (length) (depth to top)  
4 plastic  
 (size) (material)
- (6) pump Sub 10  
 (HP) (yield gpm)  
Spec  
 (type power)
- (7) electric log no  
 (yes or no)
- (8) how well bottom plugged Wood peg

CODED

CODED

CODED

DRILLERS REMARKS:

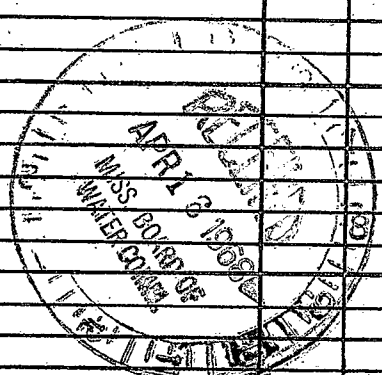

If well telescopes please sketch and show depths.

GROUND LEVEL

X			

SECTION 17

Please indicate well location X.

ADDITIONAL INFORMATION

If more than one screen, show locations of each on sketch.