

A 9

3-3-61

WATER WELL DRILLERS LOG

7 300

Date: 3-3, 1961, Driller: Chester Reeves County: Waltham
 (Name)

(1) Owner of Land:	Description & Color of Materials Sand, Clay, Red Clay, Shell, etc.	Thick- ness Feet	Depth Feet
<u>Gerald O. Burnett</u> (Name)	<u>Red clay</u>	<u>20</u>	<u>20</u>
<u>RFD 3, Jayess</u> (Address)	<u>Red sand</u>	<u>25</u>	<u>45</u>
(2) Location: <u>3 miles East of ENON</u> <u>1/4, 1/4, Sec. 7, R. 10 E</u> <u>17 miles North of Tylertown.</u> (distance) (direction) (Nearest Town)	<u>Gravel sand</u>	<u>10</u>	<u>55</u>
(3) Topography: <u>Hilly</u> (Hilly) (Flat) (Level)	<u>Red Gravel sand</u>	<u>11</u>	<u>66</u>
(4) Purpose of Well: <u>Domestic</u> (Domestic Irrigation Municipal, Industrial, Other)			

Information upon completion of well:


- (1) Diameter 4 inches.
- (2) Total Depth 66 feet.
- (3) Water Level 44 feet below top of ground.
- (4) Cased to 66, Size: 4"
- (5) Screen: Size NONE, Length _____
- (6) Were any formations sealed against pollution?
 _____ yes, no.

If YES depth of formation _____

Why _____

Drillers Remarks:

Had old Tile well -

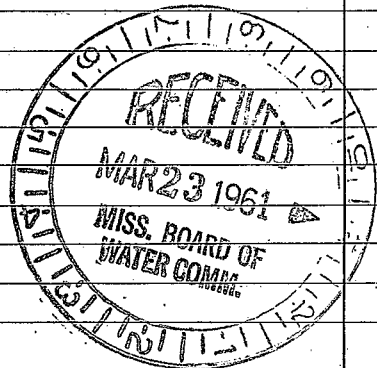

(Use Back Side)

Well No.

