

WALTHALL
A 11
6-9-71

MISSISSIPPI
BOARD OF WATER COMMISSIONERS
416 North State Street
Jackson, Mississippi 39201

CODED

WATER WELL DRILLERS LOG

6-9 1971 *Walthall Well Dr* Walthall
date well completed firm name county well located

LANDOWNER:
Rowin Holmes -
P.O. Felton, Miss
(mailing address)

description of formations encountered	from	to
<i>Red Clay</i>	<i>0</i>	<i>20</i>
<i>Red Sand</i>	<i>20</i>	<i>110</i>
<i>Coarse Sandstone</i>	<i>110</i>	<i>128</i>

WELL LOCATION:
sec. *25* T. *4* N. R. *10* E.
5 miles *E* of *ENON*
(distance) (direction) (nearest town)

WELL PURPOSE:
Home
(home, irrigation, municipal, industrial)

- WELL COMPLETION DATA:
- (1) diameter (inches) *4*
 - (2) total depth (feet) *128*
 - (3) static water level (feet) *90* below top of ground.
 - (4) casing *plastic 120* (material) (depth).
4 (size) if telescope see back.
 - (5) screen *8* (length) *120* (depth to top).
8 (size) *plastic* (material).
 - (6) pump *1* (HP) *5* (yield gpm).
elec (type power)
 - (7) electric log *no* (yes or no)
(organization running log)
 - (8) how well bottom plugged *completely*

CODED


JUN 14 1971

DRILLERS REMARKS:

MISS. DIV. OF
WATER RESOURCES

If well telescopes please sketch and show depths.

GROUND LEVEL

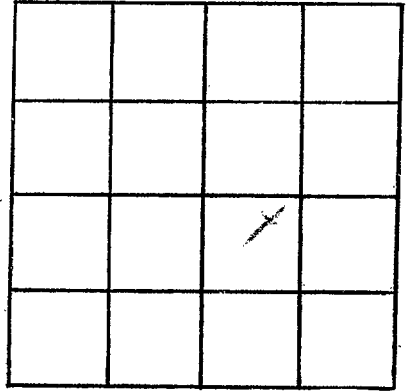

SECTION 25

Please indicate well location X.

ADDITIONAL INFORMATION

If more than one screen,
show locations of each on sketch.