

A 14 CODED
4-23-66

WATER WELL DRILLERS LOG

Date: 4/23, 1966, Driller: T. B. Andrew County Walthall
(Name)

(1) Owner of Land: Alford Boyd Jr.
(Name)
Rt. 3 Jayess, Miss
(Address)

(2) Location: 1/4, 1/4, Sec. 20 T4 R10,
Enow store at Enow
(distance) miles (direction) of (Nearest Town)

(3) Topography: _____
(Hilly) (Flat) (Level)

(4) Purpose of Well: Domestic
(Domestic Irrigation
Municipal, Industrial, Other)

| Description & Color of Materials Sand, Clay, Red Clay, Shell, etc. | Thick- ness Feet | Depth Feet |
|---|------------------------|---------------|
| <u>0' to 40'</u> <u>gray clay</u> | | |
| <u>40' to 55'</u> <u>sand</u> | | |
| <u>55' to 63'</u> <u>sand + gravel</u> | | |

Information upon completion of well:

(1) Diameter 4 inches.

(2) Total Depth 63' feet.

(3) Water Level 25 feet below top of ground.

(4) Cased to 63', Size 4"

(5) Screen: Size 4", Length 6'


(6) Were any formations sealed against pollution?
_____yes, no.

If YES depth of formation _____

Why _____

Drillers Remarks:
Plastic Well

CODED

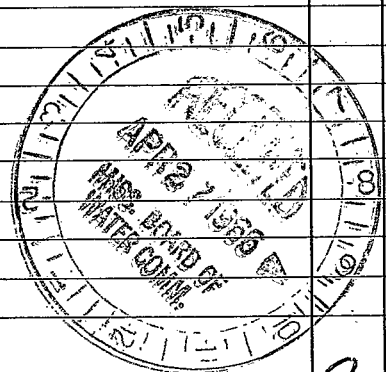

(Use Back Side)

Well No. 9

