

MISSISSIPPI

BOARD OF WATER COMMISSIONERS

416 North State Street

Jackson, Mississippi 39201

WATER WELL DRILLERS LOG

Walthall

A 18

7-66

19-14

1966 Fitzgerald Water Well Serv

Walthall

LANDOWNER: F.D. Lawrence

R.B. Johnson Mrs

(mailing address)

WELL LOCATION:

sec. 19 T. 4 N. R. 10 E. S. W. 15 miles E of Melomb

WELL PURPOSE: home (home, irrigation, municipal, industrial)

WELL COMPLETION DATA:


- (1) diameter (inches) 4
(2) total depth (feet) 82
(3) static water level (feet) 50 below above top of ground.
(4) casing plastic 74 (material) (depth)
(5) screen 8' 24' (length) (depth to top)
(6) pump 1/2 HP 7 (type power) (yield gpm)
(7) electric log NO (yes or no)
(8) how well bottom plugged Wood peg

description of formations encountered

from to

Table with 3 columns: description of formations encountered, from, to. Rows include: top soil/clay (0-15), sand/gravel (20-35), coarse gravel (15-50), chalk (10-60), coarse sandy gravel (25-85).


CODED

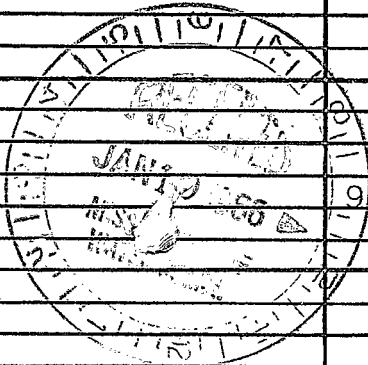

DRILLERS REMARKS:

If well telescopes please sketch and show depths.

GROUND LEVEL

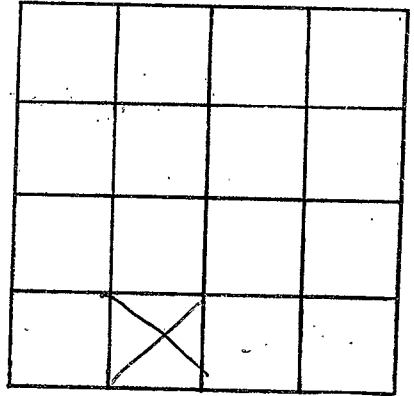

SECTION 19

Please indicate well location X.

ADDITIONAL INFORMATION

If more than one screen, show locations of each on sketch.