

**MISSISSIPPI
BOARD OF WATER COMMISSIONERS**
416 North State Street
Jackson, Mississippi 39201

WATER WELL DRILLERS LOG

Walthall

Walthall
A 17
7-68 CODED

July 13 19 *66* *Lyle Gordon Water Well Service* *Louisiana*
date well completed firm name county well located

LANDOWNER: *Howard Alex Anderson*
Joyess Rt. Miss

description of formations encountered	from	to
<i>Top Soil/Chalk</i>	<i>0</i>	<i>20</i>
<i>Red Sand</i>	<i>40</i>	<i>60</i>
<i>Chalk</i>	<i>20</i>	<i>80</i>
<i>Lime Sand</i>	<i>15</i>	<i>95</i>
<i>White Chalk</i>	<i>10</i>	<i>105</i>
<i>Coarse Sand & gravel</i>	<i>15</i>	<i>120</i>
<i>Heavy gravel</i>	<i>10</i>	<i>130</i>

(mailing address)

WELL LOCATION:
sec. *3* T. *4* N. R. *10* E.
3 miles *E* of *Joyess*
(distance) (direction) (nearest town)


WELL PURPOSE: *home*
(home, irrigation, municipal, industrial)

WELL COMPLETION DATA:

- (1) diameter (inches) *4*
- (2) total depth (feet) *129*
- (3) static water level (feet) *80* below above top of ground.
- (4) casing *galastic 121*
(material) (depth)
- 4* if telescope see back.
(size)
- (5) screen *81 121*
(length) (depth to top)
- 4 plastic*
(size) (material)
- (6) pump *1/2 sub 12*
(HP) (yield gpm)
- Electric*
(type power)
- (7) electric log *No*
(yes or no)
- (organization running log)
- (8) how well bottom plugged *Wood Peg*


CODED

DRILLERS REMARKS:

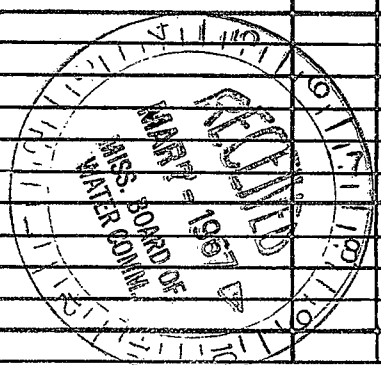

If well telescopes please sketch and show depths.

GROUND LEVEL

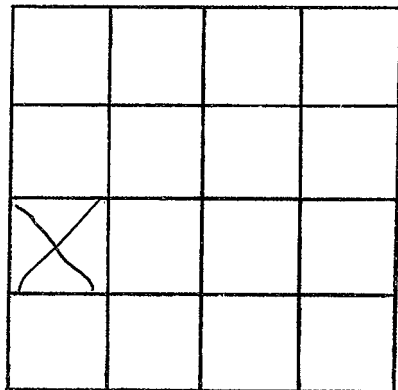

SECTION 3

Please indicate well location X.

ADDITIONAL INFORMATION

If more than one screen, show locations of each on sketch.