

MISSISSIPPI  
 BOARD OF WATER COMMISSIONERS  
 416 North State Street  
 Jackson, Mississippi 39201

WATER WELL DRILLERS LOG

CODED  
 Walthall  
 A 20  
 CODED  
 1-67

1-5 1967 E. L. Fitzgerald Water Well Co Walthall  
 date well completed firm name county well located

LANDOWNER: Jewell Dunaway

Tylertown RT3 MISS  
 (mailing address)

description of formations encountered	from	to
	<u>Top Soft Red Clay</u>	<u>0</u>
<u>Red Sand &amp; gravel</u>	<u>17</u>	<u>30</u>
<u>Sand Red</u>	<u>15</u>	<u>45</u>
<u>Coarse Sand &amp; gravel</u>	<u>16</u>	<u>61</u>

WELL LOCATION:


sec. 19 T. 4 N. R. 10 E. CODED  
 S W  
12 miles E of McComb  
 (distance) (direction) (nearest town)

WELL PURPOSE:  
 (home, irrigation, municipal, industrial)

WELL COMPLETION DATA:


- (1) diameter (inches) 4
- (2) total depth (feet) 61
- (3) static water level (feet) 45 below top of ground. CODED
- (4) casing plastic 53,  
 (material) (depth)  
4 If telescope see back.  
 (size)
- (5) screen 8", 53  
 (length) (depth to top)  
4", plastic  
 (size) (material)
- (6) pump Set 10  
 (HP) (yield gpm)  
Spec  
 (type power)
- (7) electric log NO  
 (yes or no)  
 (organization running log)
- (8) how well bottom plugged Wood peg

DRILLERS REMARKS:

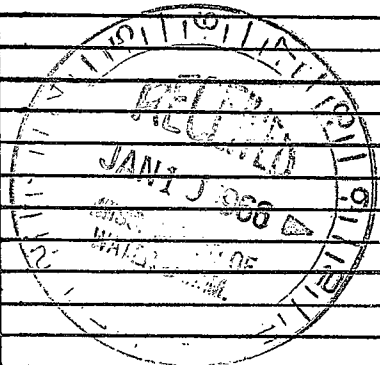

If well telescopes please sketch and show depths.

GROUND LEVEL

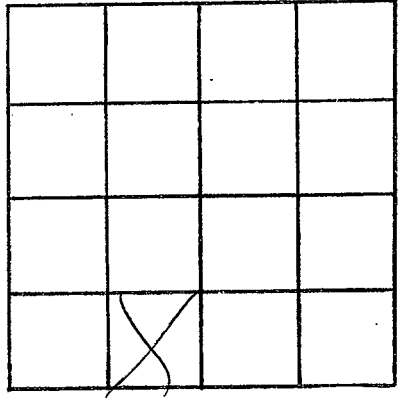

SECTION \_\_\_\_\_

Please indicate well location X.

ADDITIONAL INFORMATION

Lined area for additional information.

If more than one screen, show locations of each on sketch.