

Walthall ^{CODED}
 A 21
 4-67

MISSISSIPPI
 BOARD OF WATER COMMISSIONERS
 416 North State Street
 Jackson, Mississippi 39201
 WATER WELL DRILLERS LOG

Apr 4 19 67 Fitzgerald and Son Walthall
 date well completed firm name county well located

LANDOWNER: Cyril Ashburn

description of formations encountered	from	to

Joyner, Rt.
 (mailing address)

<u>Red Clay</u>	<u>0</u>	<u>20</u>
<u>Red Sand</u>	<u>20</u>	<u>80</u>
<u>White + Blue Chalk</u>	<u>80</u>	<u>115</u>
<u>Green sand + gravel</u>	<u>115</u>	<u>138</u>

WELL LOCATION:
 sec. 18 T. 4 N R. 10 E
 S W
6 miles NE of Prichard
 (distance) (direction) (nearest town)


WELL PURPOSE: Home
 (home, irrigation, municipal, industrial)

WELL COMPLETION DATA:

- (1) diameter (inches) 4
- (2) total depth (feet) 138
- (3) static water level (feet) 90 below above top of ground.
- (4) casing Plastic, 130'
 (material) (depth)
4"
 (size) if telescope see back.
- (5) screen 8', 130'
 (length) (depth to top)
4", Plastic
 (size) (material)
- (6) pump ? ?
 (HP) (yield gpm)
Electric
 (type power)
- (7) electric log no
 (yes or no)
 (organization running log)
- (8) how well bottom plugged wood plug


CODED

DRILLERS REMARKS:

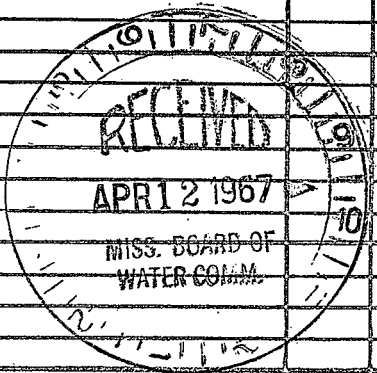

If well telescopes please sketch and show depths.

GROUND LEVEL

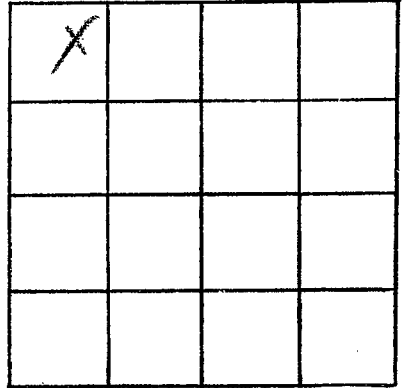

SECTION 16

Please indicate well location X.

ADDITIONAL INFORMATION

If more than one screen,
show locations of each on sketch.