

**MISSISSIPPI
BOARD OF WATER COMMISSIONERS
416 North State Street
Jackson, Mississippi 39201**

WATER WELL DRILLERS LOG

Wathall
A 23
5-67 CODED

May 25 1967 Reverend & Kump & Wathall
 date well completed firm name county well located

LANDOWNER: Louis Pope

RFD 1,
Jayas, Miss
 (mailing address)

WELL LOCATION: SW 1/4 of NE 1/4
 sec. 1 T 4 N R 10 E
4 miles @ SW - Jayas -
 (distance) (direction) (nearest town)

WELL PURPOSE: Domestic
 (home, irrigation, municipal, industrial)

WELL COMPLETION DATA:

- (1) diameter (inches) 4
- (2) total depth (feet) 110
- (3) static water level (feet) 95 below top of ground.
- (4) casing plastic, ballans (material) (depth)
- _____ if telescope see back. (size)
- (5) screen 6' 104' (length) (depth to top)
4 plastic (size) (material)
- (6) pump 1/2 Sub 12 (HP) (yield gpm)
elect (type power)
- (7) electric log No (yes or no)


_____ (organization running log)

(8) how well bottom plugged gravel plug

DRILLERS REMARKS: No petroleum well


description of formations encountered	from	to
<u>red clay</u>	<u>0</u>	<u>27</u>
<u>red cherty clay</u>		
<u>Clay</u>	<u>27</u>	<u>65</u>
<u>sand & gravel with chalk</u>	<u>65</u>	<u>98</u>
<u>clean sand gravel with sand</u>	<u>98</u>	<u>110</u>

CODED

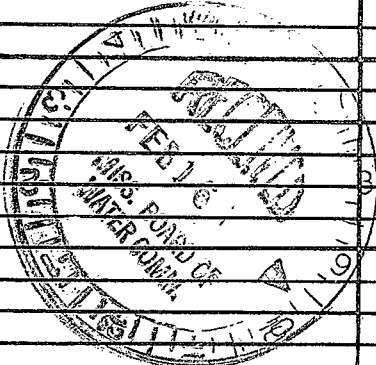

If well telescopes please sketch and show depths.

GROUND LEVEL

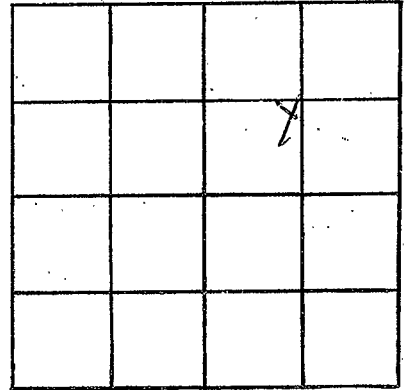

SECTION 1

Please indicate well location X.

ADDITIONAL INFORMATION

If more than one screen, show locations of each on sketch.