

MISSISSIPPI
BOARD OF WATER COMMISSIONERS
416 North State Street
Jackson, Mississippi 39201

WATER WELL DRILLERS LOG

Walthall
A 24
12-67

CODED

Dec 29 1967 date well completed
Kernell & Sons firm name
Walthall county well located

LANDOWNER: Charles Kay
Buster Sr.
RFD, Jayess
(mailing address)

description of formations encountered	from	to
Red sandy clay	0	20
Red chalk	20	45
Red sand & gravel	45	100
Red gravel sand	100	113

WELL LOCATION:
sec. 1 T. 4 N. R. 9 E
4 miles WSW of Jayess
(distance) (direction) (nearest town)

WELL PURPOSE: Home
(home, irrigation, municipal, industrial)


WELL COMPLETION DATA:

- (1) diameter (inches) 4"
- (2) total depth (feet) 113
- (3) static water level (feet) 100 below top of ground.
- (4) casing Plastic, 6" (material) 107' (depth)
- (5) screen 6" (length) 107' (depth to top)
4" Plastic (size) (material)
- (6) pump 1/2 HP (HP) 12 (yield-gpm)
Elect (type power)
- (7) electric log No (yes or no)
- (organization running log)

CODED


(8) how well bottom plugged
wood chips

DRILLERS REMARKS:
No pressure well.

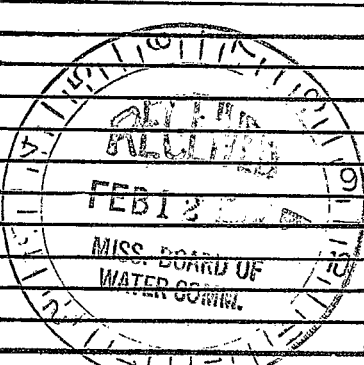

If well telescopes please sketch and show depths.

GROUND LEVEL

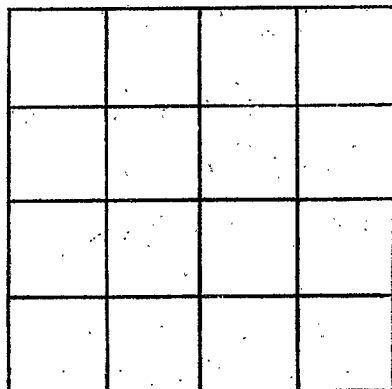

SECTION 1

Please indicate well location X.

ADDITIONAL INFORMATION

If more than one screen,
show locations of each on sketch.