

Walthall  
A25  
1-68

CODED

MISSISSIPPI  
BOARD OF WATER COMMISSIONERS  
416 North State Street  
Jackson, Mississippi 39201

WATER WELL DRILLERS LOG

1-4 date well completed 1968 Fitzgerald Water Well firm name Walthall county well located

LANDOWNER: Al Boyd

description of formations encountered

from to

Tylertown MISS RT-

Top soil & clay	0	12
Sand & gravel	12	45
Chalk	45	60
Sand & gravel	60	90

(mailing address)

WELL LOCATION:

sec. 20 T. 9 N. R. 4 E. 10E  
12 miles N of Tylertown  
(distance) (direction) (nearest town)

WELL PURPOSE: home  
(home, irrigation, municipal, industrial)

WELL COMPLETION DATA:

(1) diameter (inches) 4  
(2) total depth (feet) 100  
(3) static water level (feet) 25 below top of ground.

CODED

(4) casing plastic 84  
(material) (depth)  
4 If telescope see back.  
(size)

(5) screen 6', 84  
(length) (depth to top)  
4", Sch 40  
(size) (material)

(6) pump —  
(HP) (yield gpm)


Elec  
(type power)

(7) electric log no  
(yes or no)

(organization running log)


(8) how well bottom plugged Wood peg

DRILLERS REMARKS:

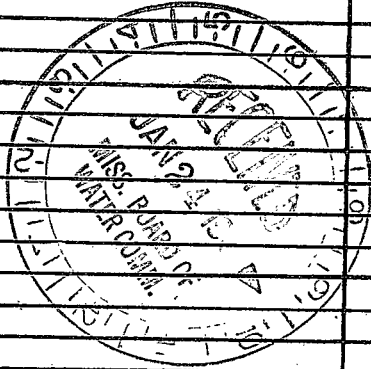

If well telescopes please sketch and show depths.

GROUND LEVEL

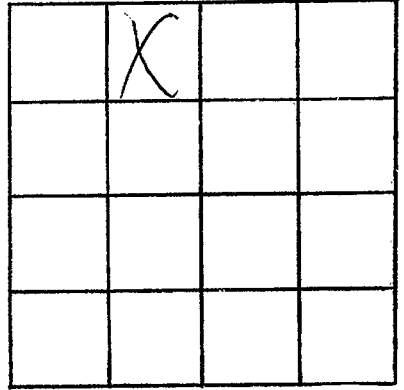

SECTION 20

Please indicate well location X.

ADDITIONAL INFORMATION

If more than one screen, show locations of each on sketch.