

Wathall
A 28
4-68

MISSISSIPPI
BOARD OF WATER COMMISSIONERS
416 North State Street
Jackson, Mississippi 39201

CODED

WATER WELL DRILLERS LOG

April 18 68 Keener well pump wathall
date well completed firm name county well located

LANDOWNER: Andrew
Wathall
RFD-Tylerboro
(mailing address)

description of formations encountered	from	to
bed clay	0	27
red sand	27	60
red chalk	60	63
sand & gravel	63	75
red gravel	75	82

WELL LOCATION:
sec 28 T 4 N R 10 E
1.2 miles N of Tylerboro
(distance) (direction) (nearest town)

WELL PURPOSE: Home
(home, irrigation, municipal, industrial)

WELL COMPLETION DATA:

(1) diameter (inches) 4"

(2) total depth (feet) 82

(3) static water level (feet) 65 below top of ground

(4) casing Plaster Bottom
(material) (depth)

(size) If telescope see back,

(5) screen 6' 59"
(length) (depth to top)

4" Plaster
(size) (material)

(6) pump old pump by
(type power) (yield/gpm)


Electric
(type power)

(7) electric log no -
(yes or no)

(organization running log)

(8) how well bottom plugged
wooden plug


CODED

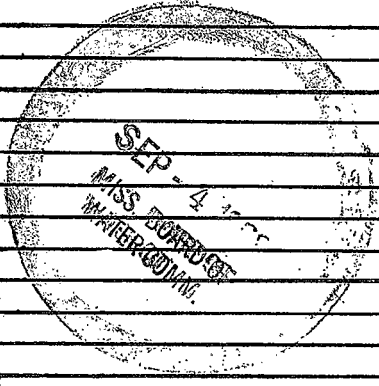

DRILLERS REMARKS:
old well
dry

If well telescopes please sketch and show depths.

GROUND LEVEL

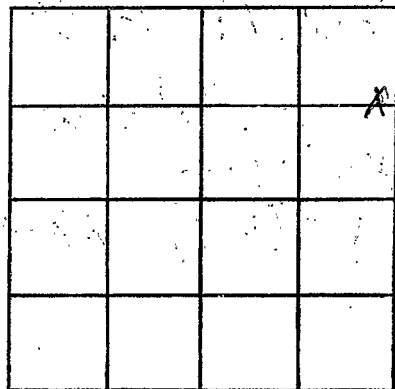

SECTION 28

Please indicate well location X.

ADDITIONAL INFORMATION

If more than one screen, show locations of each on sketch.