

MISSISSIPPI
BOARD OF WATER COMMISSIONERS
416 North State Street
Jackson, Mississippi 39201

CODED

Wattshall
A 29
7-68

CODED

WATER WELL DRILLERS LOG

Wattshall

July 16 1968 Keenes well Pump
date well completed firm name county well located

LANDOWNER

Layalford
RFD Hayles

description of formations encountered

from to

(mailing address)

Red Sandy clay	0	22
Red Sand	22	68
Clay, sandy gravel	68	75
Red chalk	75	96
Gravel	96	102
White chalk	102	104
Red gravel & Sand	104	116

WELL LOCATION:

sec 4 T 4 N R 10 E
16 1/2 miles N.W. of Tylertown
(distance) (direction) (nearest town)

WELL PURPOSE:

Home (home, irrigation, municipal, industrial)

WELL COMPLETION DATA:

- (1) diameter (inches) 4"
- (2) total depth (feet) 116'
- (3) static water level (feet) 65' below top of ground
- (4) casing Plastic, bottom (material) (depth)
- (5) screen 6' length 110' depth to top (size) (material) Plastic
- (6) pump 1/2 HP (HP) 12 (yield gpm) (type power) Electric
- (7) electric log No (yes or no)

(organization running log)

(8) how well bottom plugged

working plug


DRILLERS REMARKS:

New hole

Drilled to bottom of formation


CODED

CODED

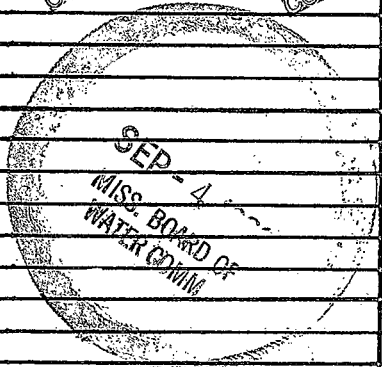

If well telescopes please sketch and show depths.

GROUND LEVEL

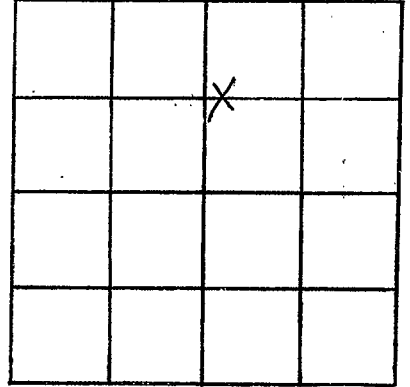

SECTION 4

Please indicate well location X.

ADDITIONAL INFORMATION

If more than one screen, show locations of each on sketch.