

Walshall
A31
12-24-68

MISSISSIPPI
BOARD OF WATER COMMISSIONERS
416 North State Street
Jackson, Mississippi 39201

CODING

CODING

WATER WELL DRILLERS LOG

Dec 24 1968 J.T. Cunningham Walshall
date well completed firm name county well located


LANDOWNER: James Griffin	description of formations encountered	from	to
Tyler town, Miss. (mailing address)			
WELL LOCATION: sec. 25 T. 4 N. R. 9 E. 3 E. S. 5 E. W. 11 miles S.E. of Brookhaven (distance) (direction) (nearest town)			
WELL PURPOSE: Home (home, irrigation, municipal, industrial)			
WELL COMPLETION DATA:			
(1) diameter (inches) 2 1/2"			
(2) total depth (feet) 149'			
(3) static water level (feet) 80' below top of ground.			
(4) casing Plastic, 1 1/2" (material) (depth)			
(size) If telescope see back.			
(5) screen 6' (length) 149' (depth to top)			
4" Plastic (size) (material)			
(6) pump 2 (HP) 5 (yield gpm)			
As.C. (type power)			
(7) electric log (yes or no)			
(organization running log)			
(8) how well bottom plugged rock			
DRILLERS REMARKS:			

JAN 28 1969

STATE OF MISSISSIPPI
DEPARTMENT OF AGRICULTURE
DIVISION OF WATER RESOURCES

If well telescopes please
sketch and show depths.

GROUND LEVEL

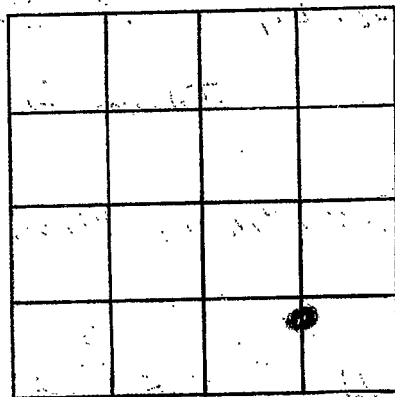

SECTION 25

Please indicate well location X.

ADDITIONAL INFORMATION

If more than one screen,
show locations of each on sketch.