

MISSISSIPPI
 BOARD OF WATER COMMISSIONERS
 416 North State Street
 Jackson, Mississippi 39201

CODED

CODED

WATER WELL DRILLERS LOG

Walshall
 A 32
 1-22-69

1-22-1969 date well completed
 Fitzgerald W V Service firm name
 Walshall county well located

LANDOWNER: Charley Brister

description of fomations encountered

from to

Tylertown RT MISS -
 (mailing address)

Reel clay	0	15
Reel sand	15	75
Reel sand + gravel	75	110
Coarse sand + gravel	110	120

WELL LOCATION:

sec 25 T 4 N R 10 E
 S W
 13 miles N of Tylertown
 (distance) (direction) (nearest town)

WELL PURPOSE: home
 (home, irrigation, municipal, industrial)

WELL COMPLETION DATA:

- (1) diameter (inches) 4
- (2) total depth (feet) 120
- (3) static water level (feet) 70 below top of ground.
- (4) casing Plastic 114 (material) (depth)
 4 (size) if telescope see back.
- (5) screen 6' 114 (length) (depth to top)
 4 plastic (size) (material)
- (6) pump 1/2 10 (HP) (yield gpm)
 Electric (type power)
- (7) electric log No (yes or no)
 (organization running log)
- (8) how well bottom plugged gravel


DRILLERS REMARKS:

FEB 13 1969

MISS. Bd. OF WATER COMMISSIONERS

If well telescopes please sketch and show depths.

GROUND LEVEL

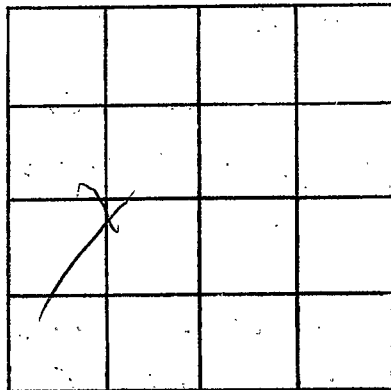

SECTION 25

Please indicate well location X.

ADDITIONAL INFORMATION

If more than one screen, show locations of each on sketch.