

Walthall  
A 33  
2-6-69

MISSISSIPPI  
BOARD OF WATER COMMISSIONERS  
416 North State Street  
Jackson, Mississippi 39201

CODED  
CODED

WATER WELL DRILLERS LOG

Feb. 6 1969 J. J. Robertson Walthall  
date well completed firm name county well located

LANDOWNER: Herbert H. H. Ford  
Tylertown, Miss.  
(mailing address)

description of formations encountered	from	to
clay sand	0	40
shales	40	60
sand & shales	60	95
chalk	95	125
sand	125	145

WELL LOCATION:  
sec. 4 T 4 N R 10 E  
S W  
10 miles North of Tylertown  
(distance) (direction) (nearest town)

WELL PURPOSE: Home  
(home, irrigation, municipal, industrial)

- WELL COMPLETION DATA:
- (1) diameter (inches) 4"
  - (2) total depth (feet) 145'
  - (3) static water level (feet) 85' below top of ground.
  - (4) casing Plastic, 139' (material) (depth)  
(size) if telescope see back.
  - (5) screen 6' 145' (length) (depth to top)  
4" Plastic (size) (material)
  - (6) pump 8 (HP) (yield gpm)  
A.C. (type power)
  - (7) electric log (yes or no)  
(organization running log)
  - (8) how well bottom plugged wood


FEB 18 1969

DRILLERS REMARKS:

MISS. BD. OF  
WATER COMM.

If well telescopes please sketch and show depths.

GROUND LEVEL

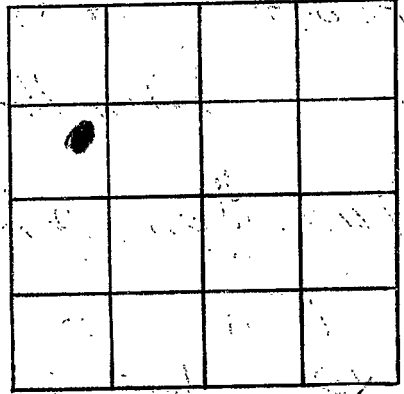

SECTION 8

Please indicate well location X.

ADDITIONAL INFORMATION

If more than one screen, show locations of each on sketch.