

Walthall
A 34
2-25-69

MISSISSIPPI
BOARD OF WATER COMMISSIONERS
416 North State Street
Jackson, Mississippi 39201

CODED

CODED

WATER WELL DRILLERS LOG

Feb 25 1969 Fitzgerald well drill Walthall
date well completed firm name county well located

LANDOWNER: S.F. Boyal
B.R. Jayes, Miss.
(mailing address)

description of formations encountered	from	to
<u>Red clay</u>	<u>0</u>	<u>20</u>
<u>Red sand & gravel</u>	<u>20</u>	<u>80</u>
<u>Coarse sand & gravel</u>	<u>80</u>	<u>90</u>

WELL LOCATION:
sec 1 T 4 N R 10 E
3 W
12 miles N of Tylahoa
(distance) (direction) (nearest town)

WELL PURPOSE: Home
(home, irrigation, municipal, industrial)

- WELL COMPLETION DATA:
- (1) diameter (inches) 4
 - (2) total depth (feet) 90'
 - (3) static water level (feet) 90 below above top of ground.
 - (4) casing Aluminum 84,
(material) (depth)
4 if telescope see back.
(size)
 - (5) screen 6, 84
(length) (depth to top)
4, plastic
(size) (material)
 - (6) pump 3/4, 6
(HP) (yield gpm)
elec
(type power)
 - (7) electric log No
(yes or no)
(organization running log)
 - (8) how well bottom plugged casual plug

CODED


MAR 13 1969

DRILLERS REMARKS:

MISS. BD. OF
WATER COMM.

If well telescopes please sketch and show depths.

GROUND LEVEL

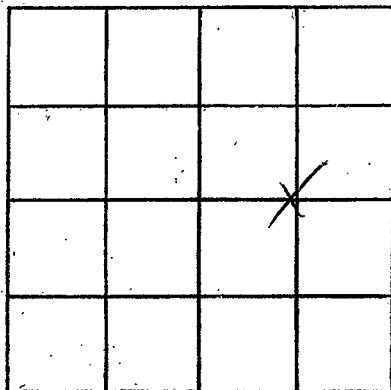

SECTION /

Please indicate well location X.

ADDITIONAL INFORMATION

If more than one screen, show locations of each on sketch.