

Walthall

A 35

12-68

MISSISSIPPI
 BOARD OF WATER COMMISSIONERS
 416 North State Street
 Jackson, Mississippi 39201

CODED

WATER WELL DRILLERS LOG

Dec 26 68 Reeves well # 1066 Walthall
 date well completed firm name county well located

LANDOWNER: George
 Fortenberry
 RFD Jaycox
 (mailing address)

description of formations encountered	from	to
yellow clay	0	27
red sandy sand	27	87
Reynolds sand	87	100

WELL LOCATION:
 sec. 17 T. 4 N. R. 10 E.
 7 miles west of Slatersville
 (distance) (direction) (nearest town)

WELL PURPOSE: Home-Dairy
 (home, irrigation, municipal, industrial)

- WELL COMPLETION DATA:
- (1) diameter (inches) 4"
 - (2) total depth (feet) 100
 - (3) static water level (feet) 77 below top of ground.
 - (4) casing Plastic Ballon (material) (depth)
 (size) if telescope see back.
 - (5) screen 6' 94' (length) (depth to top)
 4" Plastic (size) (material)
 - (6) pump 3/4 HP 12 (HP) (yield gpm)
 220' (type power)
 - (7) electric log NO (yes or no)

(organization running log)

(8) how well bottom plugged
 woodchips

DRILLERS REMARKS:
 No previous well


CODED

MAR 27 1969

MISS. Bd. of WATER COMMISSIONERS

If well telescopes please sketch and show depths.

GROUND LEVEL

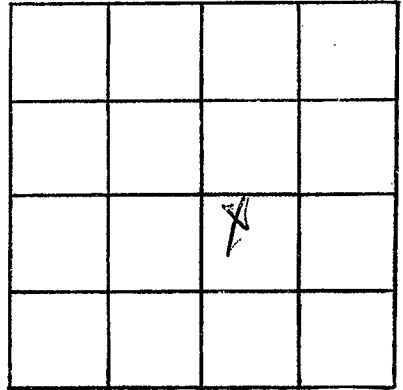

SECTION 12

Please indicate well location X.

ADDITIONAL INFORMATION

If more than one screen,
show locations of each on sketch.