

WALTHALL

A 37

9-16-69

MISSISSIPPI BOARD OF WATER COMMISSIONERS
416 North State Street
Jackson, Mississippi 39201

CODED

CODED

WATER WELL DRILLERS LOG

Sept 16 69 Reeswell Pump - Walthall
date well completed firm name county well located

LANDOWNER:

Dennis P. Martin
RD 3 Jayles
(mailing address)

description of formations encountered

from to

yellow clay 0 17
yellow chalk
cracked with sand
& gravel 17 90
coarse sand 90 114

WELL LOCATION:

sec 32 T 4 N R 10 E
10 miles N-W of Walthall
(distance) (direction) (nearest town)

WELL PURPOSE:

Home
(home, irrigation, municipal, industrial)

WELL COMPLETION DATA:

- (1) diameter (inches) 4" ^{cr}
- (2) total depth (feet) 114
- (3) static water level (feet) 71 below top of ground above
- (4) casing plastic bottom
(material) (depth)
- (5) screen 6" 108'
(length) (depth to top)
- 4" plastic
(size) (material)
- (6) pump none
(HP) (yield gpm)
- (type power)
- (7) electric log NO
(yes or no)
- (organization running log)

(8) how well bottom plugged

wooden plug

DRILLERS REMARKS:


new location

SEP 20 1969

MISS. DIV. OF
WATER CONTROL

If well telescopes please sketch and show depths.

GROUND LEVEL

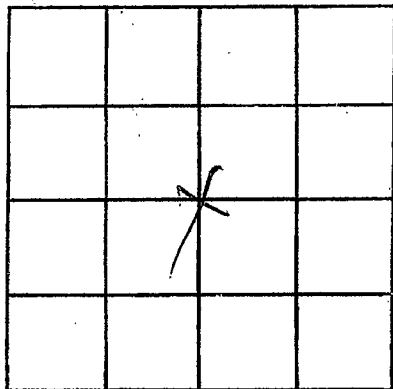

SECTION 32

Please indicate well location X.

ADDITIONAL INFORMATION

If more than one screen,
show locations of each on sketch.