

Walshall
A 38
10-1-69

MISSISSIPPI
BOARD OF WATER COMMISSIONERS
416 North State Street
Jackson, Mississippi 39201

CODED

WATER WELL DRILLERS LOG

date well completed

firm name

county well located

LANDOWNER:

description of formations
encountered

from

to

(mailing address)

WELL LOCATION:

sec 30 T 4 N R 10 E

3 1/2 miles E of Hiram

(distance) (direction) (nearest town)

WELL PURPOSE:

(home, irrigation, municipal, industrial)

WELL COMPLETION DATA:

(1) diameter (inches)

(2) total depth (feet)

(3) static water level (feet)

below
top of ground.

(4) casing

(material) (depth)

(size) If telescope see back.

(5) screen

(length) (depth to top)

(size)

(material)

(6) pump

(HP) (yield gpm)

(type power)

(7) electric log

(yes or no)

(organization running log)

(8) how well bottom plugged


DRILLERS REMARKS:

DEC 31 1969

MISS. BD. OF
WATER COM.

If well telescopes please
sketch and show depths.

GROUND LEVEL

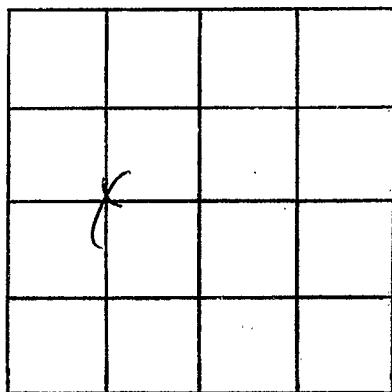

SECTION 10

Please indicate well location X.

ADDITIONAL INFORMATION

If more than one screen,
show locations of each on sketch.