

Walthall  
A 39  
2-13-70

MISSISSIPPI  
BOARD OF WATER COMMISSIONERS  
416 North State Street  
Jackson, Mississippi 39201

**CODED**

WATER WELL DRILLERS LOG

2-73 1970 Fitzgerald well serv Walthall  
date well completed firm name county well located

LANDOWNER:

description of formations encountered

from to

Sonny Hampton

RR 2 Jones, Miss.  
(mailing address)

Red clay

0 20

Red sand

20 70

Red gravel

70 95

Red sand

95 120

Coarse sand & gravel

120 130

WELL LOCATION:

sec 12 T 4 N R 10 E  
S E  
2 miles W of Tactonville  
(distance) (direction) (nearest town)

WELL PURPOSE:

Home  
(home, irrigation, municipal, industrial)

WELL COMPLETION DATA:

- (1) diameter (inches) 4
- (2) total depth (feet) 130
- (3) static water level (feet) 100 below top of ground.
- (4) casing plastic, 124  
(material) (depth)  
4 if telescope see back.  
(size)
- (5) screen 6, 124  
(length) (depth to top)  
4, plastic  
(size) (material)
- (6) pump 3/4, 5  
(HP) (yield gpm)  
Elm  
(type power)
- (7) electric log no  
(yes or no)  
(organization running log)
- (8) how well bottom plugged wood peg


FEB 27 1970

DRILLERS REMARKS:

MISS. Bd. of WATER COMMISSIONERS

If well telescopes please sketch and show depths.

GROUND LEVEL

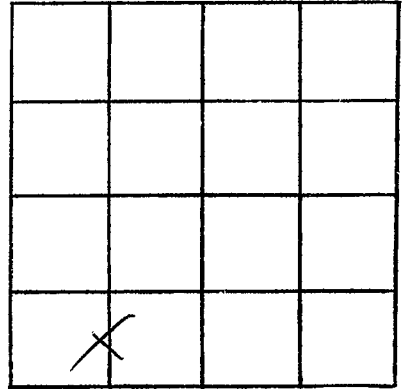

SECTION 12

Please indicate well location X.

ADDITIONAL INFORMATION

If more than one screen,  
show locations of each on sketch.