

Walthall

A 40

3-25-70

MISSISSIPPI
BOARD OF WATER COMMISSIONERS
416 North State Street
Jackson, Mississippi 39201

WATER WELL DRILLERS LOG

CODED

3-25

1970

Fitzgerald Well Serv

Walthall

date well completed

firm name

county well located

LANDOWNER:

Ralph Abner

R.R. Jones

(mailing address)

WELL LOCATION:

sec. 13 T. 4 N. R. 9 E.

4 miles ENE of Friedale
(distance) (direction) (nearest town)

WELL PURPOSE: Home
(home, irrigation, municipal, industrial)

WELL COMPLETION DATA:

- (1) diameter (inches) 4
- (2) total depth (feet) 158
- (3) static water level (feet) 105 below top of ground.
- (4) casing plastic, 150, (material) (depth)
4 (size) if telescope see back.
- (5) screen 8, 150 (length) (depth to top)
4 (size) Alustik (material)
- (6) pump 1 (HP) 6 (yield gpm)
Elec (type power)
- (7) electric log yes (yes or no)
(organization running log)
- (8) how well bottom plugged Wood Peg

description of formations encountered

from to

Red clay	0	15
Red sand	15	45
Red chalk	45	60
white chalk	60	95
fine sand	95	100
white chalk	100	120
Coarse sand	120	158

CODED


APR - 1970

MISS. BD. OF WATER COMMISSIONERS

DRILLERS REMARKS:

If well telescopes please sketch and show depths.

GROUND LEVEL

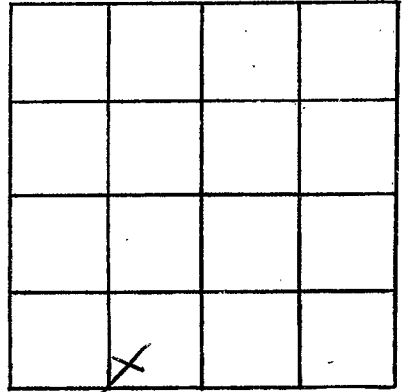

SECTION 13

Please indicate well location X.

ADDITIONAL INFORMATION

If more than one screen, show locations of each on sketch.