

MISSISSIPPI  
BOARD OF WATER COMMISSIONERS  
416 North State Street  
Jackson, Mississippi 39201

**CODED**

WATER WELL DRILLERS LOG

Walthall  
A 41  
4-4-70

Apr-4 1970 *Fitzgerald Well Serv* *Walthall*  
date well completed firm name county well located

LANDOWNER:  
*Calvin Danoway*  
*R.R. Jones, Mrs.*  
(mailing address)

description of formations encountered	from	to
<i>Red Clay</i>	<i>0</i>	<i>20</i>
<i>Red sand</i>	<i>20</i>	<i>60</i>
<i>Red gravel</i>	<i>60</i>	<i>90</i>
<i>Coarse gravel</i>	<i>90</i>	<i>110</i>
<i>Red sand</i>	<i>110</i>	<i>150</i>
<i>Coarse sand &amp; gravel</i>	<i>150</i>	<i>159</i>

WELL LOCATION:  
sec. *19* T *4* N R *10* E  
*12* miles *E* of *McComb*  
(distance) (direction) (nearest town)

WELL PURPOSE: *Drinking*  
(home, irrigation, municipal, industrial)

- WELL COMPLETION DATA:
- (1) diameter (inches) *4*
  - (2) total depth (feet) *159*
  - (3) static water level (feet) *40* below above top of ground.
  - (4) casing *plastic* (material) (depth)  
(size) *if telescope see back.*
  - (5) screen *18* (length) *100-151* (depth to top)  
*4* (size) *plastic* (material)
  - (6) pump *3* (HP) *60* (yield gpm)  
*elec* (type power)
  - (7) electric log *no* (yes or no)  
(organization running log)
  - (8) how well bottom plugged *wood peg*

**CODED**



APR 29 1970

MISS. BD. OF  
WATER COMM.

DRILLERS REMARKS:

If well telescopes please sketch and show depths.

GROUND LEVEL

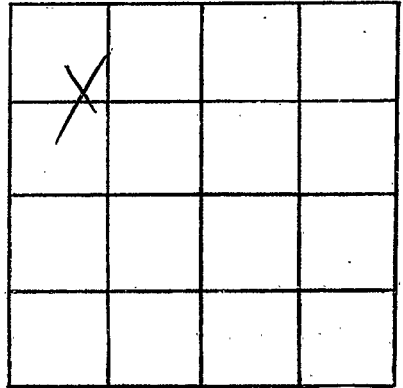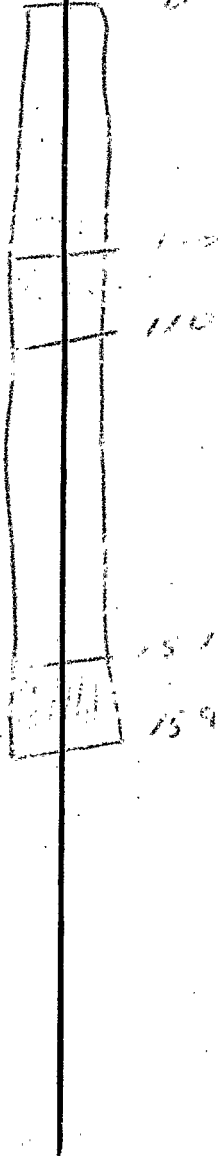

SECTION 19

Please indicate well location X.

ADDITIONAL INFORMATION

Lined area for additional information.

If more than one screen, show locations of each on sketch.