




If well telescopes please sketch and show depths.

GROUND LEVEL

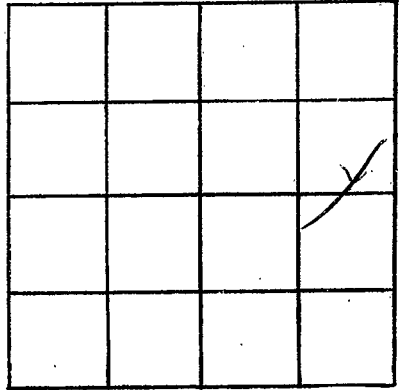

SECTION 90

Please indicate well location X.

ADDITIONAL INFORMATION

A series of horizontal lines for recording additional information.

If more than one screen, show locations of each on sketch.