

MISSISSIPPI
 BOARD OF WATER COMMISSIONERS
 416 North State Street
 Jackson, Mississippi 39201

CODED

WATER WELL DRILLERS LOG

Walthall
A 44
6-29-70

6-29 1970 Fitzgerald Well Serv Walthall
 date well completed firm name county well located

LANDOWNER: Estes Bell
R.R. Jones, Mrs. 1
 (mailing address)

description of formations encountered	from	to
<u>Red clay</u>	<u>0</u>	<u>10</u>
<u>Red sand</u>	<u>10</u>	<u>50</u>
<u>Coarse sand</u>	<u>50</u>	<u>60</u>

WELL LOCATION:
 sec. 20 T. 4 N. R. 10 E.
IN miles ENON of (nearest town)

WELL PURPOSE: Home
 (home, irrigation, municipal, industrial)

- WELL COMPLETION DATA:
- (1) diameter (inches) 4
 - (2) total depth (feet) 60
 - (3) static water level (feet) 20 below top of ground.
 - (4) casing plastic, 54, (material) (depth)
4 (size) if telescope see back.
 - (5) screen 6, 54 (length) (depth to top)
4 (size), plastic (material)
 - (6) pump 1/2, 3 (HP) (yield gpm)
Electric (type power)
 - (7) electric log no (yes or no)
 - (8) how well bottom plugged completely

CODED


DRILLERS REMARKS:

JUL 24 1970

MISS. RD. OF
 WATER COMM.

If well telescopes please sketch and show depths.

GROUND LEVEL

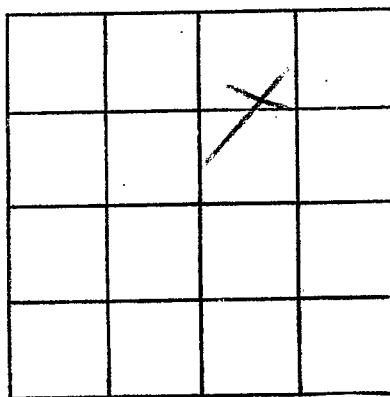

SECTION 20

Please indicate well location X.

ADDITIONAL INFORMATION

If more than one screen, show locations of each on sketch.