

Walthall
A 45
7-15-70

MISSISSIPPI
BOARD OF WATER COMMISSIONERS
416 North State Street
Jackson, Mississippi 39201

CODED


WATER WELL DRILLERS LOG

7-15-1970 date well completed
Fitzgerald firm name
Walthall county well located

LANDOWNER:	description of formations encountered	from	to
Everett Thornton R.R. Tylertown Miss. (mailing address)	Red clay Red clay Coarse sand	0 20 190	20 190 200
WELL LOCATION: sec 31 T 4 N R 10 E 17 miles NWE of Tylertown (distance) (direction) (nearest town)	Coarse sand & gravel	200	214
WELL PURPOSE: Home (home, irrigation, municipal, industrial)	CODED		
WELL COMPLETION DATA:			
(1) diameter (inches) 4			
(2) total depth (feet) 214			
(3) static water level (feet) 110 below top of ground.			
(4) casing 4" (size) if telescope see back. Plastic 206 (material) (depth)			
(5) screen 8" (length) 206 (depth to top) 4" (size) Plastic (material)			
(6) pump 1 1/2 (HP) 10 (yield gpm) Electric (type power)			
(7) electric log (yes or no) yes			
(8) how well bottom plugged seal			
DRILLERS REMARKS:	JUL 21 1970		
	ENCL. DD. OF WATER COM.		

If well telescopes please sketch and show depths.

GROUND LEVEL

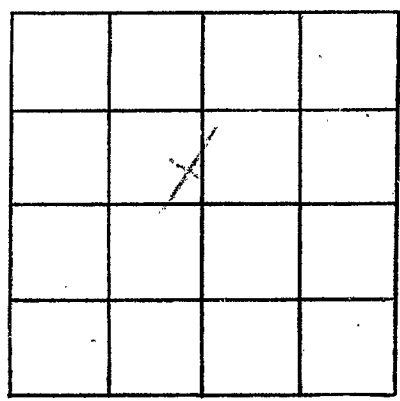

SECTION 31

Please indicate well location X.

ADDITIONAL INFORMATION

A series of horizontal lines for writing additional information, starting below the 'ADDITIONAL INFORMATION' header and extending to the bottom of the page.

If more than one screen, show locations of each on sketch.