

WALTHALL
A 47
8-5-70

MISSISSIPPI
BOARD OF WATER COMMISSIONERS
416 North State Street
Jackson, Mississippi 39201

CODED

WATER WELL DRILLERS LOG

8-5 1970 *F. L. Smallwell, Inc.* *Walthall*
date well completed firm name county well located

LANDOWNER:
NC abstract
R.R. Jones miss.
(mailing address)

description of formations encountered	from	to
<i>Red clay</i>	<i>0</i>	<i>20</i>
<i>Red sand</i>	<i>20</i>	<i>90</i>
<i>Coarse sand & gravel</i>	<i>90</i>	<i>161</i>

WELL LOCATION:
sec. *20* T *4* (N) R *10* (E)
S W
1 miles *E* of *Enon*
(distance) (direction) (nearest town)

WELL PURPOSE: *drinking*
(home, irrigation, municipal, industrial)

- WELL COMPLETION DATA:
- (1) diameter (inches) *4*
 - (2) total depth (feet) *101*
 - (3) static water level (feet) *65* below above top of ground.
 - (4) casing *plastic* *95*
(material) (depth)
4 If telescope see back.
(size)
 - (5) screen *6* *95*
(length) (depth to top)
4 *plastic*
(size) (material)
 - (6) pump *1* *8*
(HP) (yield gpm)
Ele
(type power)
 - (7) electric log *no*
(yes or no)
 - (organization running log)
 - (8) how well bottom plugged *covered*

CODED


AUG 17 1970

DRILLERS REMARKS:

MISS. BD. OF
WATER

If well telescopes please sketch and show depths.

GROUND LEVEL

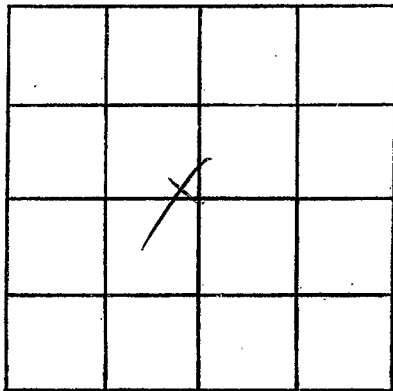

SECTION 22

Please indicate well location X.

ADDITIONAL INFORMATION

If more than one screen,
show locations of each on sketch.