

WALTHALL

~~WALTHALL~~

A 48

10-9-70

MISSISSIPPI
BOARD OF WATER COMMISSIONERS
416 North State Street
Jackson, Mississippi 39201

CODED

WATER WELL DRILLERS LOG

10-9
date well completed

19

To Fitzgerald Well Co firm name
Lawrence county well located

LANDOWNER:

Willard Alford

R.R. Jones, Miss.
(mailing address)

description of formations encountered

from

to

Red clay 0 15
Red sand 15 95
Loose sand & gravel 95 106

WELL LOCATION:

sec 10-4 N R 10E 4
S
4 miles NE of ENON
(distance) (direction) (nearest town)

WELL PURPOSE: Home
(home, irrigation, municipal, industrial)

WELL COMPLETION DATA:

- (1) diameter (inches) 4 1/2
- (2) total depth (feet) 106
- (3) static water level (feet) 60 below above top of ground.
- (4) casing Plastic 100
(material) (depth)
4 if telescope see back.
(size)
- (5) screen 6 100
(length) (depth to top)
4
(size) (material)
- (6) pump 3/4 9
(HP) (yield gpm)
Walt
(type power)
- (7) electric log Yes
(yes or no)

(organization running log)

(8) how well bottom plugged wood

DRILLERS REMARKS:


CODED

OCT 16 1970

MISS. BR. OF
WATER COMM.

If well telescopes please sketch and show depths.

GROUND LEVEL

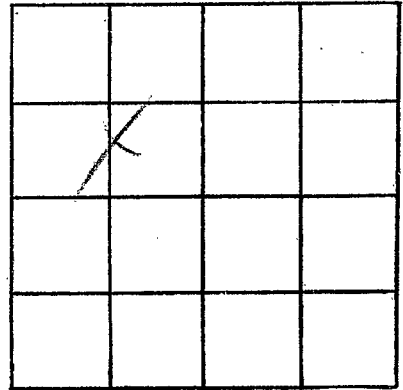

SECTION 12

Please indicate well location X.

ADDITIONAL INFORMATION

If more than one screen, show locations of each on sketch.