

WALTHALL

A49

10-27-70

MISSISSIPPI BOARD OF WATER COMMISSIONERS  
416 North State Street  
Jackson, Mississippi 39201

**CODED**

WATER WELL DRILLERS LOG

10-27 date well completed

1970

Fitzgerald

firm name

Walthall county well located

LANDOWNER:

Elvie Coon

P.R. Jones, Miss  
(mailing address)

description of formations encountered

from

to

Red clay	0	20
Red sand	20	90
Coarse sand	90	102

WELL LOCATION:

sec. 24 T 4 N R 9 E  
S W  
3 miles E of Prineville  
(distance) (direction) (nearest town)

WELL PURPOSE: Home  
(home, irrigation, municipal, industrial)

WELL COMPLETION DATA:

- (1) diameter (inches) 4
- (2) total depth (feet) 102
- (3) static water level (feet) 70 below top of ground.
- (4) casing plastic, 94 (depth)  
(material) (depth)  
4 (size) if telescope see back.
- (5) screen 8, 94 (length) (depth to top)  
4 (size) plastic (material)
- (6) pump 1/2 (HP) 12 (yield gpm)  
El (type power)
- (7) electric log no (yes or no)


**CODED**

NOV 9 - 1970

DRILLERS REMARKS:

If well telescopes please sketch and show depths.

GROUND LEVEL

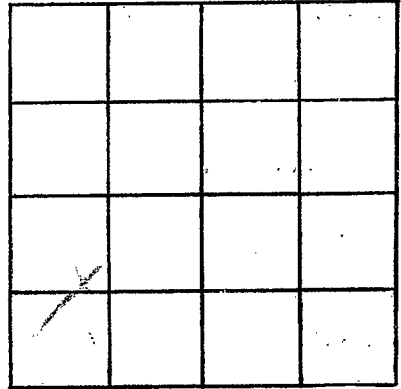

SECTION 24

Please indicate well location X.

ADDITIONAL INFORMATION

If more than one screen,  
show locations of each on sketch.