

WALTHALL
A50
10-30-70

MISSISSIPPI
BOARD OF WATER COMMISSIONERS
416 North State Street
Jackson, Mississippi 39201

CODED

WATER WELL DRILLERS LOG

10-30
date well completed

1970
firm name

Fitzgerald
Walthall
county well located

LANDOWNER:

Charles Dunaway
RR 1 Jones Miss.
(mailing address)

description of formations encountered

from to

Red clay	0	20
Red sand	20	85
Coarse gravel	85	89
White clay	89	140
Fine sand	140	150
Coarse sand	150	160

WELL LOCATION:

sec. 13 T 4 N R 9 E
S W
4 miles E of Primmale
(distance) (direction) (nearest town)

WELL PURPOSE: stone
(home, irrigation, municipal, industrial)

WELL COMPLETION DATA:

- (1) diameter (inches) 4
- (2) total depth (feet) 160
- (3) static water level (feet) 88 below top of ground.
- (4) casing plastic, 154,
(material) (depth)
4 if telescope see back.
(size)
- (5) screen 6, 154
(length) (depth to top)
4, plastic
(size) (material)
- (6) pump 1, 6
(HP) (yield gpm)
class
(type power)
- (7) electric log X
(yes or no)

CODED

(organization running log)

(8) how well bottom plugged: Washed


NOV 9 - 1970

DRILLERS REMARKS:

MISS. BD. OF
WATER COMMISSIONERS

If well telescopes please sketch and show depths.

GROUND LEVEL

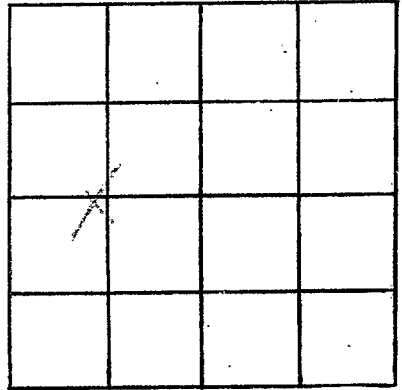

SECTION 123

Please indicate well location X.

ADDITIONAL INFORMATION

If more than one screen, show locations of each on sketch.