

MISSISSIPPI  
BOARD OF WATER COMMISSIONERS  
416 North State Street  
Jackson, Mississippi 39201

**CODED**

WATER WELL DRILLERS LOG

WALTHALL

WALTHALL  
A51  
2-68

date well completed

19

Fitzgerald water well

firm name

county well located

LANDOWNER: James Marbury

Box 155 MISS RT#

description of formations encountered

from to

1-2 3/4' clay	0	13
5' sand	13	20
1' 1/2' red sand	20	1/5

(mailing address)

WELL LOCATION:


sec 21 T 4 (N) S R 10 (E) W  
1/2 miles (distance) N (direction) of Fitzgerald (nearest town)

WELL PURPOSE: house  
 (home, irrigation, municipal, industrial)

WELL COMPLETION DATA:

- (1) diameter (inches) 4
- (2) total depth (feet) 113
- (3) static water level (feet) 70 below above top of ground.
- (4) casing plastic 109 (material) (depth)  
4 (size) if telescope see back.
- (5) screen 6' (length) 109 (depth to top)  
4 (size) 50440 (material)
- (6) pump 1/2 Sub (HP) 15 (yield gpm)  
elec (type power)
- (7) electric log no (yes or no)  
 (organization running log)
- (8) how well bottom plugged Wash 20'


**CODED**

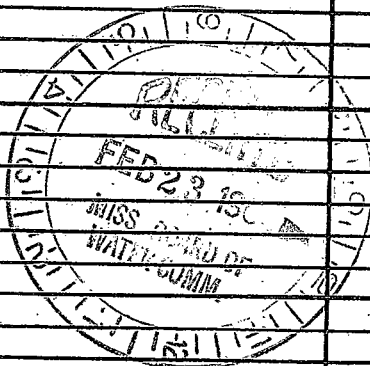

DRILLERS REMARKS:

If well telescopes please sketch and show depths.

GROUND LEVEL

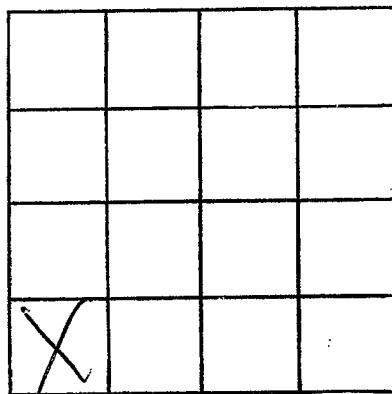

SECTION *2*

Please indicate well location X.

ADDITIONAL INFORMATION

If more than one screen, show locations of each on sketch.