

WALTHALL
A 52
11-12-70

MISSISSIPPI
BOARD OF WATER COMMISSIONERS
416 North State Street
Jackson, Mississippi 39201

CODED

WATER WELL DRILLERS LOG

11-12 1970 Fitzgerald well Walthall
date well completed firm name county well located

LANDOWNER:
Hewitt Cathin
R.R. Jones mess
(mailing address)

WELL LOCATION:
sec. 13 T 4 (N) R. 9 (E)
S W
3 miles NE of Princeton
(distance) (direction) (nearest town)

WELL PURPOSE: Home
(home, irrigation, municipal, industrial)

- WELL COMPLETION DATA:
- (1) diameter (inches) 4
 - (2) total depth (feet) 162
 - (3) static water level (feet) 100 below top of ground.
 - (4) casing plastic, 154,
(material) (depth)
4 If telescope see back.
(size)
 - (5) screen 8, 154
(length) (depth to top)
4, plastic
(size) (material)
 - (6) pump 3/4, 15
(HPY) (yield gpm)
elec
(type power)
 - (7) electric log ny
(yes or no)
(organization running log)
 - (8) how well bottom plugged completely

description of formations encountered	from	to
Red clay	0	20
Red sand	20	90
Red gravel	90	110
Red sand	110	150
Coarse sand & gravel	150	162


CODED

DRILLERS REMARKS:

NOV 16 1970

If well telescopes please sketch and show depths.

GROUND LEVEL

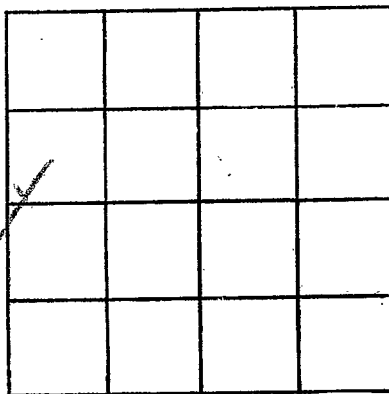

SECTION 13

Please indicate well location X.

ADDITIONAL INFORMATION

If more than one screen, show locations of each on sketch.