

WALTHALL
 A 53
 10-30-70

MISSISSIPPI
 BOARD OF WATER COMMISSIONERS
 416 North State Street
 Jackson, Mississippi 39201

CODED

WATER WELL DRILLERS LOG

7 Oct 1970 J.T. Anderson Walthall
 date well completed firm name county well located

LANDOWNER:
 Harold Pittalis
 (mailing address)

WELL LOCATION:
 sec. 5 T. 4 N. R. 10 E
 5 miles west of Jayess
 (distance) (direction) (nearest town)

WELL PURPOSE:
 (home, irrigation, municipal, industrial)

- WELL COMPLETION DATA:
- (1) diameter (inches) 4
 - (2) total depth (feet) 92
 - (3) static water level (feet) 65 below top of ground.
 - (4) casing (material) PL, (depth) 92, (size) if telescope see back.
 - (5) screen (length) 6, (depth to top) 92, (size) 4, (material) PL
 - (6) pump (HP) 1, (yield gpm) 8, (type power) electric
 - (7) electric log (yes or no)
 - (organization running log)
 - (8) how well bottom plugged wood

description of formations encountered	from	to
Clay	0	25
Cherty Sand	25	45
Sand, Red clay	45	65
Cherty Sand	65	70
Sand	70	92

CODED


DEC 10 1970

DRILLERS REMARKS:

MISS. BD. OF
 WATER COMM.

If well telescopes please sketch and show depths.

GROUND LEVEL

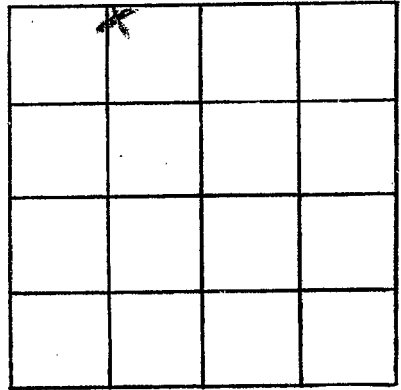

SECTION 5

Please indicate well location X.

ADDITIONAL INFORMATION

If more than one screen, show locations of each on sketch.