

WALTHALL
 A54
 11-23-70

MISSISSIPPI
 BOARD OF WATER COMMISSIONERS
 416 North State Street
 Jackson, Mississippi 39201

CODED

WATER WELL DRILLERS LOG

11-23 1970 *Fitzgerald* firm name *Walthall* county well located

LANDOWNER:
Vernon Thornhill
B.R. Joyner, miss.
 (mailing address)

description of formations encountered	from	to
<i>Red clay</i>	<i>0</i>	<i>20</i>
<i>Red sand</i>	<i>20</i>	<i>80</i>
<i>Red gravel</i>	<i>80</i>	<i>100</i>
<i>Coarse sand</i>	<i>100</i>	<i>122</i>

WELL LOCATION:
 sec. *27* T *4* N R *10* E
3 miles *S* of *Evon*
 (distance) (direction) (nearest town)

WELL PURPOSE:
Home
 (home, irrigation, municipal, industrial)

WELL COMPLETION DATA:

(1) diameter (inches) *4*

(2) total depth (feet) *122*

(3) static water level (feet) *80* below top of ground.

(4) casing *plastic*, *116*,
 (material) (depth)
4 If telescope see back.
 (size)

(5) screen *6*, *116*
 (length) (depth to top)
4, *plastic*
 (size) (material)

(6) pump *1*, *6*
 (HP) (yield gpm)
elec
 (type power)

(7) electric log *no*
 (yes or no)

(organization running log)

CODED

(8) how well bottom plugged *ready*


DRILLERS REMARKS:

DEC 17 1970

MISS. DEPT. OF
 WATER RESOURCES

If well telescopes please sketch and show depths.

GROUND LEVEL

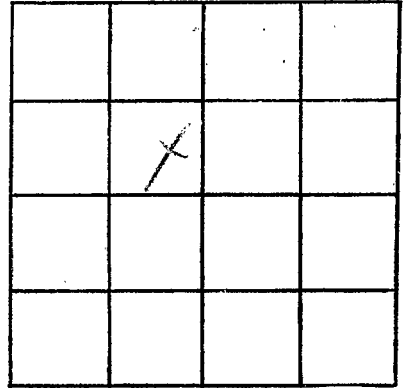

SECTION 27

Please indicate well location X.

ADDITIONAL INFORMATION

If more than one screen,
show locations of each on sketch.