

WALTHALL

~~REDE~~

A 57

3-25-71

MISSISSIPPI  
BOARD OF WATER COMMISSIONERS  
416 North State Street  
Jackson, Mississippi 39201

CODED

WATER WELL DRILLERS LOG

3-25-71

19

Greene Water Well Contractor

county well located

LANDOWNER: Doyle Cothorn

P.O. Box 784

Monticello, Miss.

(mailing address)

description of formations  
encountered

from

to

citronelle

0

160

WELL LOCATION:

sec. 25 T 4 N R 9 E  
13 miles NW of Tylertown  
(distance) (direction) (nearest town)

WELL PURPOSE: home  
(home, irrigation, municipal, industrial)

WELL COMPLETION DATA:

- (1) diameter (inches) 6"
- (2) total depth (feet) ~~160~~ 142
- (3) static water level (feet) 30 below top of ground.
- (4) casing PVC 134 ~~134~~ ~~134~~  
(material) (depth)

~~XXXX~~ 4" if telescope see back.  
(size)

- (5) screen 8' 134  
(length) (depth to top)

.010 PVC  
(size) (material)

- (6) pump did not install  
(HP) (yield gpm)

(type power)

- (7) electric log no.  
(yes or no)

(organization running log)

- (8) how well bottom plugged wood

CODED


APR 20 1971

MISS. BD. OF  
WATER COMM.

DRILLERS REMARKS:

If well telescopes please sketch and show depths.

GROUND LEVEL

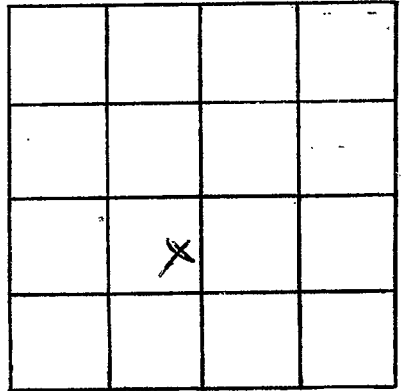

SECTION 25

Please indicate well location X.

ADDITIONAL INFORMATION

If more than one screen,  
show locations of each on sketch.