

WALTHALL

A 58

3-24-71

MISSISSIPPI BOARD OF WATER COMMISSIONERS  
416 North State Street  
Jackson, Mississippi 39201

CODED

WATER WELL DRILLERS LOG

March 24 1971 Chester Kerner Walthall  
date well completed firm name county well located

LANDOWNER: Louise Green

description of formations encountered

from to

RFD  
Jayes  
(mailing address)

Red clay 0 27  
Red chalk 27 46  
Red Sandy sand 46 53  
Sand & gravel 53 106

WELL LOCATION:

sec. 14 T. 4 N. R. 10 E  
13 miles N of Tylertown  
(distance) (direction) (nearest town)

WELL PURPOSE: Home  
(home, irrigation, municipal, industrial)

WELL COMPLETION DATA:

- (1) diameter (inches) 4"
- (2) total depth (feet) 106
- (3) static water level (feet) 51 below top of ground. 55 below surface
- (4) casing Plast. bottom  
(material) (depth)
- (size) If telescope see back.
- (5) screen 6' 100  
(length) (depth to top)  
4" Plast  
(size) (material)
- (6) pump 1/2 Sub 1/2  
(HP) (yield gpm)  
Electric  
(type power)
- (7) electric log No  
(yes or no)

CODED

(organization running log)

(8) how well bottom plugged completely

DRILLERS REMARKS:


Newhall

MAY 20 1971

MISS. Bd. OF WATER COMM.

If well telescopes please sketch and show depths.

GROUND LEVEL

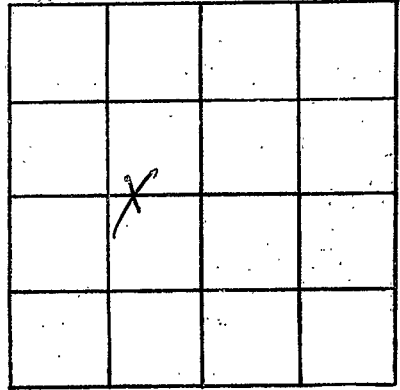

SECTION 14

Please indicate well location X.

ADDITIONAL INFORMATION

If more than one screen,  
show locations of each on sketch.