

WAZT HALL  
 A 59  
 4-28-71

MISSISSIPPI  
 BOARD OF WATER COMMISSIONERS  
 416 North State Street  
 Jackson, Mississippi 39201

**CODED**

WATER WELL DRILLERS LOG

4-28-71 date well completed  
 Dean Trimmer Drilling Co. firm name  
 Walthall county well located

LANDOWNER:  
 Polly Mae Kattig  
 Route 3 James Miss.  
 (mailing address)

description of formations encountered	from	to
top soil	0	1
red clay	1	24
red sand	24	75
water sand	75	110

WELL LOCATION:  
 sec. 24 T 40 N R 100 E  
 22 miles W of Columbus  
 (distance) (direction) (nearest town)

WELL PURPOSE: home use  
 (home, irrigation, municipal, industrial)

- WELL COMPLETION DATA:
- (1) diameter (inches) 2"
  - (2) total depth (feet) 110
  - (3) static water level (feet) 79 below top of ground.
  - (4) casing plastic 100' (material) (depth)
  - (size) if telescope see back.
  - (5) screen 7' 103' (length) (depth to top)
  - 2" plastic (size) (material)
  - (6) pump 1 (HP) (yield gpm)
  - (type power)
  - (7) electric log (meter no)
  - (organization running log)
  - (8) how well bottom plugged

**CODED**


MAY 1 1971

DRILLERS REMARKS:

MISS. BD. OF  
 WATER COMM.

If well telescopes please sketch and show depths.

GROUND LEVEL

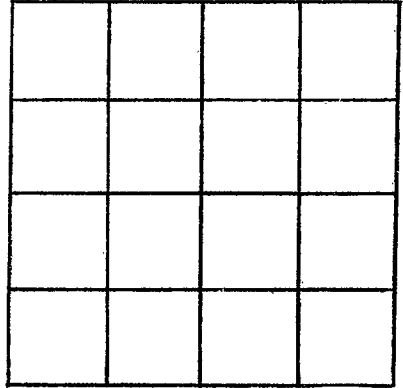

SECTION \_\_\_\_\_

Please indicate well location X.

ADDITIONAL INFORMATION

If more than one screen, show locations of each on sketch.