

WALTHALL
 A-600
 6-3-71

MISSISSIPPI
 BOARD OF WATER COMMISSIONERS
 416 North State Street
 Jackson, Mississippi 39201

CODED

WATER WELL DRILLERS LOG

6-3 1971 *Flycatcher Well* Walthall
 date well completed firm name county well located

LANDOWNER:

Luttrell Sanders
R.R. Jones, Miss.
 (mailing address)

description of formations encountered

from to

<i>Red clay</i>	6	20
<i>Red sand</i>	20	80
<i>Red gravel</i>	80	130
<i>Coarse sand & gravel</i>	130	139

WELL LOCATION:

sec. 2 T. 4 N. R. 10 E
4 miles WNW of Luttrell
 (distance) (direction) (nearest town)

WELL PURPOSE:

Home
 (home, irrigation, municipal, industrial)

WELL COMPLETION DATA:

- (1) diameter (inches) 4
- (2) total depth (feet) 139
- (3) static water level (feet) 80 below above top of ground.
- (4) casing plastic 131
 (material) (depth)
2 if telescope see back.
 (size)
- (5) screen 8 131
 (length) (depth to top)
4 plastic
 (size) (material)
- (6) pump 1 6
 (HP) (yield gpm)
elec
 (type power)
- (7) electric log no
 (yes or no)

CODED

(organization running log)

(8) how well bottom plugged good


JUN 14 1971

DRILLERS REMARKS:

MISS. BD. OF
 WATER COMM.

If well telescopes please sketch and show depths.

GROUND LEVEL

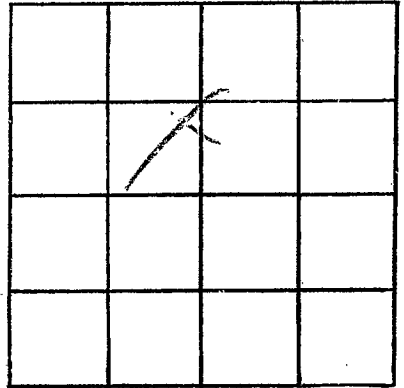

SECTION 2

Please indicate well location X.

ADDITIONAL INFORMATION

If more than one screen, show locations of each on sketch.