

WALTHALL
AG1
10-7-71

MISSISSIPPI
BOARD OF WATER COMMISSIONERS
416 North State Street
Jackson, Mississippi 39201

WATER WELL DRILLERS LOG

CODED

10-7-71 date well completed 21 firm name county well located

LANDOWNER:	description of formations encountered	from	to
Julius L. Barent	Red Clay	6	70
R.B. Jernigan (mailing address)	Red sand	20	90
	Coarse sand	90	100
WELL LOCATION:			
sec. 33 T. 4(N) S. R. 10(E)			
1/2 miles E of Iron (distance) (direction) (nearest town)			
WELL PURPOSE: Home			
(home, irrigation, municipal, industrial)			
WELL COMPLETION DATA:			
(1) diameter (inches) 4			
(2) total depth (feet) 100			
(3) static water level (feet) 70 below above top of ground.			
(4) casing <u>plastic</u> , 94 (material), (depth)			
4 (size) if telescope see back.			
(5) screen 6, 94 (length), (depth to top)			
4 (size), plastic (material)			
(6) pump 1/2, 10 (HP), (yield gpm)			
elm (type power)			
(7) electric log no (yes or no)			
(organization running log)			
(8) how well bottom plugged <u>weal py</u>			
DRILLERS REMARKS:			


CODED

OCT 28 1971

MISS. BD. OF
WATER COM.

If well telescopes please sketch and show depths.

GROUND LEVEL

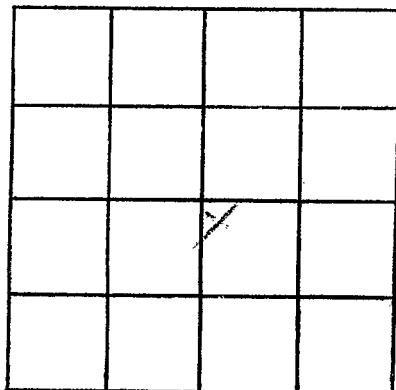

SECTION 33

Please indicate well location X.

ADDITIONAL INFORMATION

If more than one screen,
show locations of each on sketch.