

WALTHAM  
A 84  
9-4-71

MISSISSIPPI  
BOARD OF WATER COMMISSIONERS  
416 North State Street  
Jackson, Mississippi 39201

WATER WELL DRILLERS LOG

**CODED**

Sept 4 1971 date well completed  
71 Chester Keenes firm name  
county well located

LANDOWNER: James Travers  
RFD Jayles  
(mailing address)

description of formations encountered	from	to
Red clay	0	17
Red sand	17	78
hard gravel sand	78	110

WELL LOCATION:  
sec 4 T 4 N R 10 E  
13 miles N.W. of Tipton  
(distance) (direction) (nearest town)

WELL PURPOSE: home  
(home, irrigation, municipal, industrial)


- WELL COMPLETION DATA:
- (1) diameter (inches) 4" 110
  - (2) total depth (feet) 110
  - (3) static water level (feet) 86 below top of ground above
  - (4) casing Plast Ballast (material) (depth)
  - (size) if telescope see back.
  - (5) screen 6" 104 (length) (depth to top)
  - 1 1/2" Plast (size) (material)
  - (6) pump 1/2 Sub 12 (HP) (yield gpm)
  - Elect (type power)
  - (7) electric log No (yes or no)
  - (organization running log)
  - (8) how well bottom plugged

**CODED**

DRILLERS REMARKS:  
all well dry

If well telescopes please sketch and show depths.

GROUND LEVEL

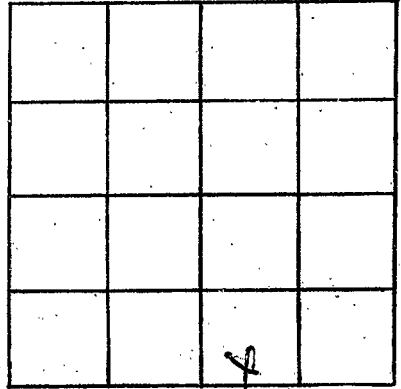

SECTION 21

Please indicate well location X:

ADDITIONAL INFORMATION

If more than one screen, show locations of each on sketch.