

WALTHALL  
 A 3365  
 11-18-71

MISSISSIPPI  
 BOARD OF WATER COMMISSIONERS  
 416 North State Street  
 Jackson, Mississippi 39201

NOV 28 1971  
**CODED**  
 MISS.  
 WA.

WATER WELL DRILLERS LOG


11-18 date well completed 71 firm name *F. L. ...* Walthall county well located

| LANDOWNER:   | description of formations encountered | from      | to         |
|--|---------------------------------------|-----------|------------|
| <i>Ernitt Lotton</i>   |                                       |           |            |
| <i>R.R. Tilton</i><br>(mailing address)                      | <i>Red clay</i>                       | <i>0</i>  | <i>20</i>  |
|  | <i>Red sand &amp; gravel</i>          | <i>20</i> | <i>80</i>  |
|  | <i>Coarse sand</i>                    | <i>80</i> | <i>120</i> |
| WELL LOCATION:   |                                       |           |            |
| sec. <i>4</i> T <i>4</i> S R <i>10</i> E                     |                                       |           |            |
| <i>10</i> miles <i>N</i> of <i>...</i>                       |                                       |           |            |
| (distance) (direction) (nearest town)                        |                                       |           |            |
| WELL PURPOSE:  |                                       |           |            |
| (home, irrigation, municipal, industrial)                    |                                       |           |            |
| WELL COMPLETION DATA:  |                                       |           |            |
| (1) diameter (inches) <i>4</i>                               |                                       |           |            |
| (2) total depth (feet) <i>120</i>                            |                                       |           |            |
| (3) static water level (feet) <i>85</i> below top of ground. |                                       |           |            |
| (4) casing <i>Plastic</i> , <i>112</i> (material) (depth)    |                                       |           |            |
| <i>4</i> (size) if telescope see back.                       |                                       |           |            |
| (5) screen <i>3</i> , <i>112</i> (length) (depth to top)     |                                       |           |            |
| <i>4</i> , <i>Plastic</i> (size) (material)                  |                                       |           |            |
| (6) pump <i>1/2</i> , <i>9</i> (HP) (yield gpm)              |                                       |           |            |
| <i>...</i> (type power)                                      |                                       |           |            |
| (7) electric log <i>no</i> (yes or no)                       |                                       |           |            |
| (organization running log)                                   |                                       |           |            |
| (8) how well bottom plugged <i>at road peg</i>               |                                       |           |            |
| DRILLERS REMARKS:  |                                       |           |            |

**CODED**

If well telescopes please sketch and show depths.

GROUND LEVEL

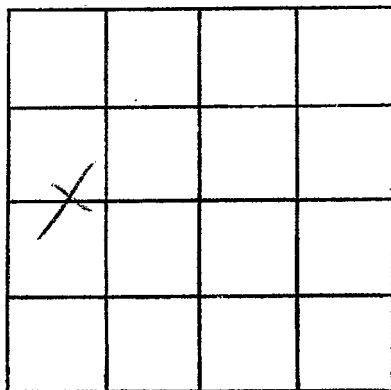

SECTION 4

Please indicate well location X.

ADDITIONAL INFORMATION

If more than one screen,  
show locations of each on sketch.