

WALTHALL

MISSISSIPPI  
BOARD OF WATER COMMISSIONERS  
416 North State Street  
Jackson, Mississippi 39201

**CODED**  
Walthall

WATER WELL DRILLERS LOG

~~11-23-71~~  
A 67  
11-23-71

23 Nov. 1971  
date well completed

S. P. Waterwell  
firm name

~~Walthall~~  
county well located

LANDOWNER:  
Marion Stockton  
McComb  
(mailing address)

description of formations encountered	from	to
Clay	0	25
Clay & Sand	25	65
Clay	45	70
Sand	70	85
Clay	75	110
Sand	110	150

WELL LOCATION:  
sec. 30 T. 4 N. R. 10 E.  
S W  
4 miles East of Prichard  
(distance) (direction) (nearest town)

WELL PURPOSE:  
(home, irrigation, municipal, industrial)

- WELL COMPLETION DATA:
- (1) diameter (inches) 4
  - (2) total depth (feet) 150
  - (3) static water level (feet) 80 below top of ground
  - (4) casing (material) PL (depth) 144  
If telescope see back. (size)
  - (5) screen (length) 6 (depth to top) 144  
(size) 4 (material) PL
  - (6) pump (HP) 4 (yield gpm) 8  
electric (type power)
  - (7) electric log (yes or no)
  - (organization running log)
  - (8) how well bottom plugged used

**CODED**


JAN 12 1972

MISS. BD. OF  
WATER COMM.

DRILLERS REMARKS:

If well telescopes please sketch and show depths.

GROUND LEVEL

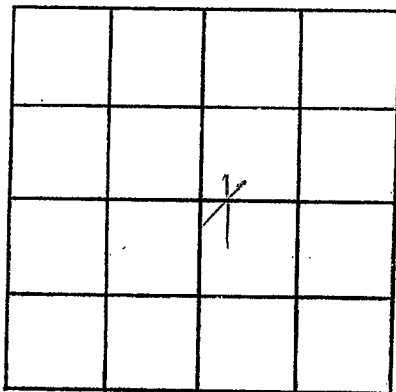

SECTION 30

Please indicate well location X.

ADDITIONAL INFORMATION

If more than one screen,  
show locations of each on sketch.