

**WALTHALL**  
**A 69**  
**2-9-72**

MISSISSIPPI  
 BOARD OF WATER COMMISSIONERS  
 416 North State Street  
 Jackson, Mississippi 39201

**CODED**

**WATER WELL DRILLERS LOG**

Feb 9 19 72 General Well Drilling Walthall  
 date well completed firm name county well located

LANDOWNER:	description of formations encountered	from	to
<u>Paul M. Daniel</u>			
<u>P.R. <del>James</del> <sup>JAMES</sup> <del>James</del> <sup>ms</sup></u> (mailing address)	<u>Red clay</u>	<u>0</u>	<u>20</u>
WELL LOCATION:	<u>Red sand</u>	<u>20</u>	<u>90</u>
sec. <u>25</u> T. <u>4</u> N. <u>5</u> S. R. <u>9</u> E.	<u>Red sand &amp; gravel</u>	<u>90</u>	<u>130</u>
<u>4</u> miles <u>E</u> of <u>Brindley</u> (distance) (direction) (nearest town)	<u>Coarse sand &amp; gravel</u>	<u>130</u>	<u>144</u>
WELL PURPOSE: <u>Home</u> (home, irrigation, municipal, industrial)			
WELL COMPLETION DATA:			
(1) diameter (inches) <u>4</u>			
(2) total depth (feet) <u>144</u>			
(3) static water level (feet) <u>80</u> below top of ground.			
(4) casing <u>plastic</u> <u>136</u> (material) (depth)			
<u>4</u> (size) if telescope see back.			
(5) screen <u>8</u> <u>136</u> (length) (depth to top)			
<u>4</u> <u>plastic</u> (size) (material)			
(6) pump <u>1/2</u> <u>10</u> (HP) (yield gpm)			
<u>Cal</u> (type power)			
(7) electric log <u>no</u> (yes or no)			
(organization running log)			
(8) how well bottom plugged <u>wood plug</u>			
DRILLERS REMARKS:			


**CODED**

FEB 28 1972

MISS. Bd. of  
 WATER COMM.

If well telescopes please sketch and show depths.

GROUND LEVEL

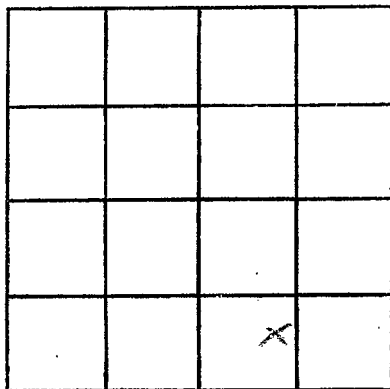

SECTION 25

Please indicate well location X.

ADDITIONAL INFORMATION

If more than one screen, show locations of each on sketch.