

CODED

MISSISSIPPI
BOARD OF WATER COMMISSIONERS
416 North State Street
Jackson, Mississippi 39201.

WATER WELL DRILLERS LOG

WALTHALL
A 71
3-20-72

70 March 1972 Spr Waterwell Walthall
date well completed firm name county well located

LANDOWNER:
Frank Causey
P.O. 5 Tylertown
(mailing address)

WELL LOCATION:
sec. 2 T. 4 N R. 10 E
7 miles N of Tylertown
(distance) (direction) (nearest town)

WELL PURPOSE:
(home, irrigation, municipal, industrial)

- WELL COMPLETION DATA:
- (1) diameter (inches) 4
 - (2) total depth (feet) 135
 - (3) static water level (feet) 70 below above top of ground.
 - (4) casing PI 129
(material) (depth)
 if telescope see back.
(size)
 - (5) screen 6 129
(length) (depth to top)
4 PI
(size) (material)
 - (6) pump 1/2 8
(HP) (yield gpm)
Electric
(type power)
 - (7) electric log
(yes or no)

(organization running log)
 - (8) how well bottom plugged wood

description of formations encountered	from	to
<u>Clay</u>	<u>0</u>	<u>18</u>
<u>Clay & Shale</u>	<u>18</u>	<u>35</u>
<u>Clay</u>	<u>35</u>	<u>65</u>
<u>Gravelly clay</u>	<u>65</u>	<u>80</u>
<u>Clay</u>	<u>80</u>	<u>105</u>
<u>Gravel</u>	<u>105</u>	<u>135</u>

CODED


MAY 22 1972

MISS. DEP. OF
AGRICULTURE
OFFICE OF
WATER RESOURCES

DRILLERS REMARKS:

If well telescopes please sketch and show depths.

GROUND LEVEL

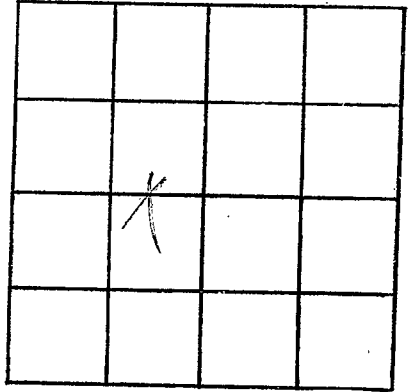

SECTION 2

Please indicate well location X.

ADDITIONAL INFORMATION

Lined area for additional information.

If more than one screen, show locations of each on sketch.