

MISSISSIPPI  
BOARD OF WATER COMMISSIONERS  
416 North State Street  
Jackson, Mississippi 39201

WATER WELL DRILLERS LOG

**CODED**

WALTHALL  
A 72  
3-17-72

March 1972 S&P Waterwell Walthall  
date well completed firm name county well located

LANDOWNER:  
Walter Mace  
Rt 3 Tylerton  
(mailing address)

description of formations encountered	from	to
<u>Clay</u>	<u>0</u>	<u>25</u>
<u>Chalk</u>	<u>25</u>	<u>40</u>
<u>Sandstone</u>	<u>60</u>	<u>80</u>
<u>Chalk</u>	<u>80</u>	<u>95</u>
<u>Sand</u>	<u>95</u>	<u>120</u>

WELL LOCATION:  
sec. 1 T. 4 N. R. 10 E.  
7 miles N of Tylerton  
(distance) (direction) (nearest town)

WELL PURPOSE:  
(home, irrigation, municipal, industrial)

- WELL COMPLETION DATA:
- (1) diameter (inches) 4
  - (2) total depth (feet) 120
  - (3) static water level (feet) 70 below top of ground.
  - (4) casing 41 124  
(material) (depth)
  - \_\_\_\_\_ if telescope see back.  
(size)
  - (5) screen 6 114  
(length) (depth to top)
  - 1/4" 41  
(size) (material)
  - (6) pump 1/2 8  
(HP) (yield gpm)
  - Electric  
(type power)
  - (7) electric log \_\_\_\_\_  
(yes or no)
  - \_\_\_\_\_ (organization running log)
  - (8) how well bottom plugged Wood

**CODED**


MAY 22 1972

REPRODUCED FROM THE  
MISSISSIPPI STATE ARCHIVES  
SERIALS ACQUISITION  
SERIALS ACQUISITION

DRILLERS REMARKS:  
\_\_\_\_\_  
\_\_\_\_\_

If well telescopes please sketch and show depths.

GROUND LEVEL

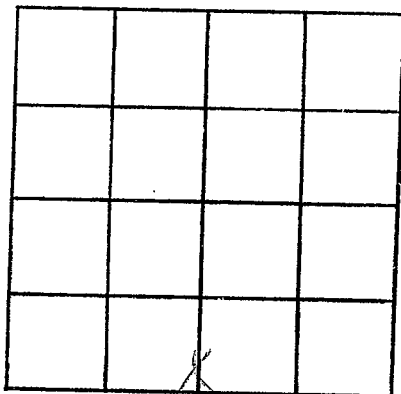

SECTION 1

Please indicate well location X.

ADDITIONAL INFORMATION

If more than one screen,  
show locations of each on sketch.